

CARD MUST BE TYPED

State of Kansas
NOTICE OF INTENTION TO DRILL
(see rules on reverse side)

CARD MUST BE SIGNED

Starting Date: September 20 84
month day year

OPERATOR: License # 6771
Name Ozark Enterprises
Address Box 427
City/State/Zip Logan, Kansas 67646
Contact Person Steve Morrison
Phone 913-689-4276
9087

CONTRACTOR: License # 9087
Name R. & C. Drilling Co., Inc.
City/State Hays, Kansas 67601

Well Drilled For:	Well Class:	Type Equipment:
<input checked="" type="checkbox"/> Oil <input type="checkbox"/> Swd	<input checked="" type="checkbox"/> Infield	<input checked="" type="checkbox"/> Mud Rotary
<input type="checkbox"/> Gas <input type="checkbox"/> Inj	<input type="checkbox"/> Pool Ext.	<input type="checkbox"/> Air Rotary
<input type="checkbox"/> OWWO <input type="checkbox"/> Expl	<input type="checkbox"/> Wildcat	<input type="checkbox"/> Cable

If OWWO: old well info as follows:

Operator

Well Name

Comp Date Old Total Depth

Projected Total Depth 3350 feet

Projected Formation at TD 50' below BKC

Expected Producing Formations LKC

I certify that we will comply with K.S.A. 55-101, et seq., plus eventually plugging hole to K.C.C. specifications.

Date 9-17-84 Signature of Operator or Agent Stephen P. Morrison

API Number 15- 147-20,459-00-00
SE NE NW Sec 3 Twp 5S S, Rge 18
4150 Ft North from Southeast Corner of Section
2970 Ft West from Southeast Corner of Section
(Note: Locate well on Section Plat on reverse side)

East
 West

Nearest lease or unit boundary line 1130 feet.
County Phillips
Lease Name Armstrong Well# 3
Domestic well within 330 feet: yes no
Municipal well within one mile: yes no


Depth to Bottom of fresh water 100 feet
Lowest usable water formation Dakota
Depth to Bottom of usable water 850 feet
Surface pipe by Alternate: 1 2
Surface pipe to be set 200' feet
Conductor pipe if any required N/A feet
Ground surface elevation 1891 feet MSL
This Authorization Expires 3-18-85
Approved By 9-18-84 PC

W.H. KOHE 9/18/84

**Must be filed with the K.C.C. five (5) days prior to commencing well
This card void if drilling not started within six (6) months of date received by K.C.C.**

Important procedures to follow :

**A Regular Section of Land
1 Mile = 5,280 Ft.**

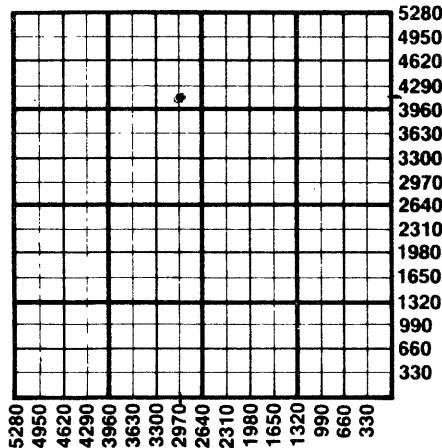

1. Notify District office before setting surface casing.
2. Set surface casing by circulating cement to the top.
3. File completion forms ACO-1 with K.C.C. within 90 days of well completion, following instructions on ACO-1, side 1, and including copies of wireline logs.
4. Notify District office 48 hours prior to old well workover or re-entry.
5. Prior to plugging, prepare a plugging plan, then obtain agreement from the appropriate district office for an approved plugging plan.
6. Submit plugging report (CP-4) to K.C.C. after plugging is completed.
7. Obtain an approved injection docket number before disposing of salt water.
8. Notify K.C.C. within 10 days when injection commences or terminates.
9. If an alternate 2 completion, cement in the production pipe from below any usable water to surface within 120 days of spud date.

RECEIVED
STATE CORPORATION COMMISSION

**State Corporation Commission of Kansas
Conservation Division
200 Colorado Derby Building
Wichita, Kansas 67202
(316) 263-3238**

SEP 18 1984
CONSERVATION DIVISION
Wichita, Kansas

9-18-84