

This form shall be filed in duplicate with the Kansas Corporation Commission, 200 Colorado Derby Building, Wichita, Kansas 67202, within ten days after the completion of the well, regardless of how the well was completed.

Attach separate letter of request if the information is to be held confidential. If confidential, only file one copy. Information on side one will be of public record and side two will then be held confidential.

Circle one: Oil, Gas, Dry, SWD, OWWO, Injection. Type and complete ALL sections. Applications must be filed for dual completion, commingling, SWD and injection.

Attach wireline logs (i.e. electrical log, sonic log, gamma ray neutron log, etc.). KCC # (316) 263-3238. (Rules 82-2-105 & 82-2-125)

OPERATOR KRM Petroleum Corporation
ADDRESS 820 Guaranty Bank Building
817 Seventeenth Street
Denver, Colorado 80202

API NO. 15-147-20,358
COUNTY Phillips
FIELD

\*\*CONTACT PERSON James Alan Townsend
PHONE 303/573-6555

PROD. FORMATION
LEASE Patton


PURCHASER
ADDRESS

WELL NO. #1-9
WELL LOCATION C SW NE

DRILLING KANDRILCO, Ltd.
CONTRACTOR Bldg. 1 - Suite 207
ADDRESS 555 N. Woodlawn
Wichita, Kansas 67208

1980 Ft. from east Line and
1980 Ft. from north Line of
the SEC. 9 TWP. 5S RGE. 17W

WELL PLAT

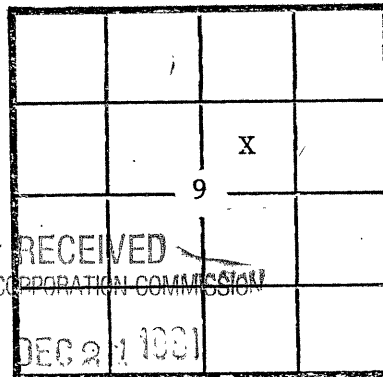

KCC
KGS
(Office Use)

PLUGGING Sun Oilwell Cementing
CONTRACTOR P.O. Box 169
ADDRESS Great Bend, Kansas 67530

TOTAL DEPTH 3560' PBDT

SPUD DATE 11/27/81 DATE COMPLETED 12/06/81

ELEV: GR 1875' DF 1880 KB 1883

DRILLED WITH (CABLE) ROTARY (AIR) TOOLS

Amount of surface pipe set and cemented 5 jts.

CONSERVATION DIVISION
Wichita, Kansas
Tool Used?

AFFIDAVIT

STATE OF Colorado, COUNTY OF Denver SS, I,

James Alan Townsend OF LAWFUL AGE, BEING FIRST DULY SWORN UPON HIS OATH, DEPOSES THAT HE IS Manager of Operations (FOR)(OF) K.R.M. Petroleum Corporation OPERATOR OF THE Patton LEASE, AND IS DULY AUTHORIZED TO MAKE

THIS AFFIDAVIT FOR AND ON THE BEHALF OF SAID OPERATOR, THAT WELL NO. 1-9 ON SAID LEASE HAS BEEN COMPLETED AS OF THE 6th DAY OF December, 19 81, AND THAT ALL INFORMATION ENTERED HEREIN WITH RESPECT TO SAID WELL IS TRUE AND CORRECT.

FURTHER AFFIANT SAITH NOT.

SUBSCRIBED AND SWORN BEFORE ME THIS 18th DAY OF December, 19 81.

(S) James Alan Townsend

Martha Seidel
NOTARY PUBLIC
Martha Seidel

MY COMMISSION EXPIRES: My Commission Expires Aug. 8, 1984

\*\*The person who can be reached by phone regarding any questions concerning this information. Within 45 days of completion, a witnessed initial test by the Commission is required if the well produces more than 25 BOPD or is located in a Basic Order Pool.

**SIDE TWO**

**WELL LOG**

SHOW GEOLOGICAL MARKERS, LOGS RUN, OR OTHER DESCRIPTIVE INFORMATION.

Show all important zones of porosity and contents thereof; cored intervals, and all drill-stem tests, including depth interval tested, cushion used, time tool open, flowing and shut-in pressures, and recoveries.

FORMATION DESCRIPTION, CONTENTS, ETC.	TOP	BOTTOM	NAME	DEPTH
<p>DST #1: (3104'-3134') K.C.                      IHP=1606                      15" IFP=119-119                      30" ISIP=1076                      15" FFP=129-129                      30" FSIP=1066                      FHP=1527                      Rec. 200' watery mud.</p> <p>DST #2: (3203'-3221') K.C.                      IHP=1655                      30" IFP=60-109                      60" ISIP=1165                      60" FFP=139-208                      120" FSIP=1145                      FHP=1635                      Rec. 45' muddy salt water.</p>			Anhydrite Topeka Heenber Toronto Kansas City B/Kansas City Arbuckle RTD	1383 (+ 500) 2858 (- 975) 3064 (-1181) 3090 (-1207) 3106 (-1223) 3344 (-1461) 3506 (-1623) LTD 3562

Report of all strings set — surface, intermediate, production, etc. **CASING RECORD** (New) or (Used)

Purpose of string	Size hole drilled	Size casing set (in O.D.)	Weight lbs/ft.	Setting depth	Type cement	Sacks	Type and percent additives
Surface	12 1/4	8 5/8	24#	202	Common	150	2% gel, 3% CaCl

LINER RECORD			PERFORATION RECORD		
Top, ft.	Bottom, ft.	Sacks cement	Shots per ft.	Size & type	Depth interval

TUBING RECORD	
Size	Setting depth

ACID, FRACTURE, SHOT, CEMENT SQUEEZE RECORD		
Amount and kind of material used		Depth interval treated

Date of first production	Producing method (flowing, pumping, gas lift, etc.)	Gravity

RATE OF PRODUCTION PER 24 HOURS	Oil	Gas	Water %	Gas-oil ratio
	bbls.	MCF	bbls.	CFPB
Disposition of gas (vented, used on lease or sold)			Perforations	

December 9, 1981

CONTRACTOR'S WELL LOG

OPERATOR: KRM Petroleum Corporation  
CONTRACTOR: KANDRILCO, Ltd.  
WELL NAME: Patton #1-9  
LOCATION: C SW NE Section 9, T5S-R17W  
Phillips County, Kansas  
API NO.: 15-147-20,358-50-00  
COMMENCED: November 27, 1981  
COMPLETED: December 6, 1981  
*cm*

Drilled 222' of 12 1/4" hole. Set 202' of new 8 5/8" 24# casing at 202' with 150 sacks common - 3% CaCl, 2% gel. Cement did circulate to surface. Plug was down at 11:00 p.m., November 27, 1981.

<u>FORMATION</u>	<u>TOP'</u>	<u>BOTTOM'</u>
Post Rock & Sand	0	222
Sand & Shale	222	882
Sand, Shale & Red Bed	882	1282
Sand & Shale	1282	1892
Sand, Shale & Lime	1892	2459
Shale & Lime	2459	2955
Lime & Shale	2955	3134
Lime	3134	3418
Lime & Chert	3418	3560

RTD 3560'. Plugged to abandon. Cemented with 135 sacks 50-50 pozmix, 4% gel, 3% CaCl. Set 70 sacks at 720', 40 sacks at 210', 10 sacks at 40', 10 sacks Rathole and 5 sacks Mousehole. Plugging was completed at 12:00 a.m. December 6, 1981.


STATE OF KANSAS, COUNTY OF SEDGWICK, SS:

I, C. K. Morrison, President, KANDRILCO, Ltd., do hereby state that the above is a true and correct copy of the Driller's Log for the KRM Petroleum Corporation Patton #1-9 well located in Phillips County, Kansas.


KANDRILCO, Ltd.

  
C.K. Morrison - President

Subscribed and sworn to before me, a Notary Public, in and for the County and State aforesaid, as of this 9th day of December, 1981.

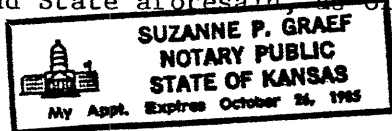

My Commission Expires: October 26, 1985

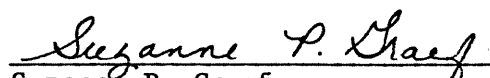  
Suzanne P. Graef  
Notary Public