


15-147-00127-00-00

Give All Information Completely
Make Required Affidavit
Mail or Deliver Report to:
Conservation Division
State Corporation Commission
212 North Market, Insurance Bldg.
Wichita, Kansas

WELL PLUGGING RECORD

Phillips County. Sec. 31 Twp 5S Rge. 19 (X) (W)

NORTH

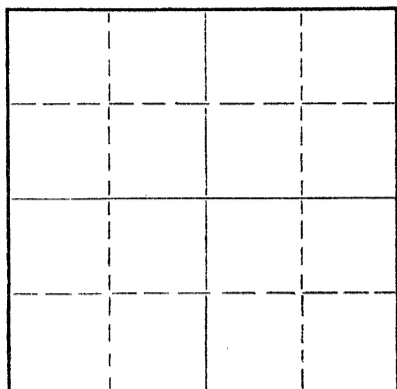

Locate well correctly on above
Section Plat

Location as "NE/CNW/SW" or footage from lines C NW NW
Lease Owner Leben Drilling, Inc. and Wm. Martin
Lease Name Hill Well No. 1
Office Address 905 Central Building Wichita 2, Kansas
Character of Well (completed as Oil, Gas or Dry Hole) dry hole
Date well completed 12-15-60 19
Application for plugging filed 12-15-60 19
Application for plugging approved 12-15-60 19
Plugging commenced 12-15-60 19
Plugging completed 12-15-60 19
Reason for abandonment of well or producing formation dry hole

If a producing well is abandoned, date of last production 19
Was permission obtained from the Conservation Division or its agents before plugging was commenced? Yes

Name of Conservation Agent who supervised plugging of this well Eldon Petty
Producing formation _____ Depth to top _____ Bottom _____ Total Depth of Well 3615 Feet
Show depth and thickness of all water, oil and gas formations.

OIL, GAS OR WATER RECORDS

CASING RECORD

FORMATION	CONTENT	FROM	TO	SIZE	PUT IN	PULLED OUT
				8-5/8"	228'	

Describe in detail the manner in which the well was plugged, indicating where the mud fluid was placed and the method or methods used in introducing it into the hole. If cement or other plugs were used, state the character of same and depth placed, from _____ feet to _____ feet for each plug set.

Bottom plug @ 340' w/20 sx. cement
Middle plug @ 180' w/20 sx. cement
Top plug @ 40' w/10 sx. cement, 1/2 sx. hulls

RECEIVED
STATE CORPORATION COMMISSION
DEC 23 1960
12-23-1960
CONSERVATION DIVISION
Wichita, Kansas

(If additional description is necessary, use BACK of this sheet)
Name of Plugging Contractor Leben Drilling, Inc.
Address 905 Central Building Wichita 2, Kansas

STATE OF KANSAS, COUNTY OF SEDGWICK, ss.
Frank Hamlin (employee of owner) or (owner or operator) of the above-described well, being first duly sworn on oath, says: That I have knowledge of the facts, statements, and matters herein contained and the log of the above-described well as filed and that the same are true and correct. So help me God.

(Signature) Frank Hamlin
905 Central Bldg. Wichita 2, Kansas
(Address)

SUBSCRIBED AND SWORN TO before me this 15th day of December, 19 60

My commission expires July 27, 1964
Bette J. Behymer Notary Public.



15-147-D 0127-00-00

DRILLER'S LOG

COMPANY:	WILLIAM MARTIN
CONTRACTOR:	LEBEN DRILLING, INC.
FARM:	HILL #1
LOCATION:	0 NW NW SEC. 31-58-19W PHILLIPS COUNTY, KANSAS
COMMENCED:	12-6-60
COMPLETED:	12-14-60

0	40	Surface Soil & Post Rock
40	228	Sand, Shale & Shells
228	700	Shells, Shale & Sand
700	1200	Shale, Shells & Redbed
1200	1360	Sand
1360	1640	Redbed & Shale
1640	1685	Anhydrite
1685	1900	Redbed & Shale
1900	2170	Shale & Shells
2170	2540	Shale & Lime
2540	2700	Lime & Shale
2700	2915	Lime
2915	3025	Lime
3025	3160	Lime & Shale
3160	3287	Lime
3287	3320	Lime
3320	3360	Lime
3360	3402	Lime
3402	3475	Lime
3475	3550	Lime
3550	3615	Lime & Shale
	<u>3615</u>	Rotary Total Depth - D & A

Set 8 5/8" surface casing @ 228' with 160 sacks Sunset cement.

I, Frank Hamlin, do hereby certify that the above and foregoing is a true and correct copy of the log of the Hill #1, located 0 NW NW of Section 31, Township 5 South, Range 19 West, Phillips County, Kansas, as reflected by the files of Leben Drilling, Inc.

Frank Hamlin
Frank Hamlin

STATE OF KANSAS)
) SS
COUNTY OF SEDGWICK)

Subscribed and sworn to before me, a Notary Public, in and for Sedgwick County, Kansas, this 22nd day of December, 1960.

Bette J. Behmer
Bette J. Behmer, Notary Public

My Commission Expires:
July 27, 1964