


STATE OF KANSAS
STATE CORPORATION COMMISSION

15-147-00092-00-00
WELL PLUGGING RECORD

Give All Information Completely
Make Required Affidavit
Mail or Deliver Report to:
Conservation Division
State Corporation Commission
800 Biting Building
Wichita, Kansas

NORTH

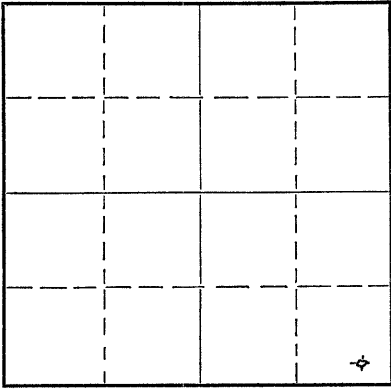

Locate well correctly on above
Section Plat

Phillips County, Sec. 31 Twp. 5 Rge. (E) 19 (W)
Location as "NE/CNW $\frac{1}{4}$ SW $\frac{1}{4}$ " or footage from lines SE SE SE
Lease Owner Isern Drilling Company
Lease Name Hill Well No. 1
Office Address Box 45, Ellinwood, Kansas
Character of Well (completed as Oil, Gas or Dry Hole) Dry Hole
Date well completed 4-27-53 19
Application for plugging filed 4-27-53 19
Application for plugging approved 4-27-53 19
Plugging commenced 4-27-53 19
Plugging completed 4-27-53 19
Reason for abandonment of well or producing formation Dry Hole
If a producing well is abandoned, date of last production 19
Was permission obtained from the Conservation Division or its agents before plugging was commenced? Yes

Name of Conservation Agent who supervised plugging of this well Eldon Petty
Producing formation Depth to top Bottom Total Depth of Well 3560 Feet
Show depth and thickness of all water, oil and gas formations.

OIL, GAS OR WATER RECORDS

CASING RECORD

Formation	Content	From	To	Size	Put In	Pulled Out
	Surface Pipe	0	210'	8-5/8"	210'	None

Describe in detail the manner in which the well was plugged, indicating where the mud fluid was placed and the method or methods used in introducing it into the hole. If cement or other plugs were used, state the character of same and depth placed, from feet to feet for each plug set.

Filled hole with heavy mud. Set rock bridge
at 200'. Cemented with 15 sacks cement. Mudded
up to 35'. Cemented with 10 sacks cement. Plugged
to base of cellar.

RECORDED
05-01-1953

(If additional description is necessary, use BACK of this sheet)

Correspondence regarding this well should be addressed to Isern Drilling Company
Address P.O. Box 45, Ellinwood, Kansas

STATE OF KANSAS, COUNTY OF BARTON, ss.
M. M. Shropshire (employee of owner) or (owner or operator) of the above-described well,
being first duly sworn on oath, says: That I have knowledge of the facts, statements, and matters herein contained and the log of the above-described well as filed and that the same are true and correct. So help me God.

(Signature) M. M. Shropshire
Lyons, Kansas (Address)

SUBSCRIBED AND SWORN to before me this 28th day of April, 1953

My commission expires Feb. 10, 1955.

George A. Meyer
Notary Public.

22-7377-s 4-49-10M



PLUGGING
FILE SEC 31 T 5 R 19 W
BOOK PAGE 28 LINE 2

15-147-00092-00-00

WELL LOG

Isern Drilling Company etal, Owner - Hill #1
SE/4 SE/4 SE/4 Section 31, Township 5, Range 19W,
Phillips County, Kansas

Elevation: 2043 DF

Figures indicate bottom of formation
0 to 40 shale & shells

Pipe Record:

8-5/8" set at 210'

Tops: RBM

Heebner 3238
Toronto 3258
Lansing 3278
Arbuckle 3531

70 sand
695 shale & shells
710 sand
775 shale & shells
913 sand & shale
1300 sand
1602 shale & shells
1637 Anhydrite
2525 shale & shells
2725 shale & lime
2850 shale & shells
3330 lime & shale
3531 lime
3560 Arbuckle
3560 Total Depth D&A

Rotary Commenced 4-19-53
Completed 4-28-53

STATE OF KANSAS)
COUNTY OF BARTON) SS

I, M. M. Shropshire, Drilling Superintendent of the above-described well,
being first duly sworn on oath, declare: That I have knowledge of the facts,
statements and matters herein contained pertaining to the log of the above-
described well, as filed, and that the same are true and correct.

M. M. Shropshire

Subscribed and Sworn to before me this 30th day of April, 1953.

George A. Meyer

My commission expires Feb. 10, 1955.

RECEIVED
STATE CORPORATION COMMISSION
MAY 1 1953
CONSERVATION DIVISION
Wichita, Kansas

PLUGGING
FILE SEC-31-T-5-R-19W
BOOK PAGE 98 LINE 9