


Give All Information Completely
Make Required Affidavit
Mail or Deliver Report to:
Conservation Division
State Corporation Commission
800 Biting Building
Wichita, Kansas

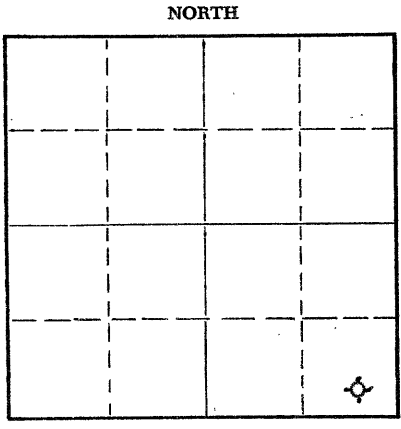

Locate well correctly on above Section Flat

Phillips County. Sec. 17 Twp. 5 Rge. 19W (E) W (W)
Location as "NE/CNW/SW" or footage from lines SE SE SE
Lease Owner D. G. Hansen -- C-G Drilling Co.
Lease Name FOX Well No. 1
Office Address 107 Rule Building, Wichita, Kansas
Character of Well (completed as Oil, Gas or Dry Hole) Dry Hole
Date well completed 8-6 1954
Application for plugging filed 8-6 1954
Application for plugging approved 8-6 1954
Plugging commenced 8-6 1954
Plugging completed 8-6 1954
Reason for abandonment of well or producing formation Too low structurally

If a producing well is abandoned, date of last production -- 19--
Was permission obtained from the Conservation Division or its agents before plugging was commenced? Yes

Name of Conservation Agent who supervised plugging of this well Eldon Petty, Hays, Kansas
Producing formation -- Depth to top -- Bottom -- Total Depth of Well 3695 Feet
Show depth and thickness of all water, oil and gas formations.

OIL, GAS OR WATER RECORDS

CASING RECORD

FORMATION	CONTENT	FROM	TO	SIZE	PUT IN	PULLED OUT
				8-5/8"	189.75	None

Describe in detail the manner in which the well was plugged, indicating where the mud fluid was placed and the method or methods used in introducing it into the hole. If cement or other plugs were used, state the character of same and depth placed, from _____ feet to _____ feet for each plug set.

Filled hole with mud to 185'; set plug; 1/2 sack hulls, 15 sacks cement. Filled hole with mud to 40'; set plug then filled to top with 10 sacks cement, 1/2 sack hulls.

(If additional description is necessary, use BACK of this sheet)

Name of Plugging Contractor C-G DRILLING CO.
Address 107 Rule Building, Wichita, Kansas

STATE OF KANSAS, COUNTY OF SEDGWICK, ss.
Vicky Jacobs (employee of owner) or (~~conservator~~) of the above-described well, being first duly sworn on oath, says: That I have knowledge of the facts, statements, and matters herein contained and the log of the above-described well as filed and that the same are true and correct. So help me God.

(Signature) Vicky Jacobs Office Manager
107 Rule Building, Wichita, Kansas
(Address)

SUBSCRIBED AND SWORN TO before me this 10th day of August, 1954

My commission expires June 17, 1957

Barbara Donaldson Notary Public.

PLUGGING
FILE SEC 17 T 5 R 19W
BOOK PAGE 55 LINE 14

RECEIVED
STATE CORPORATION COMMISSION
08-11-1954
AUG 11 1954
CONSERVATION DIVISION
Wichita, Kansas

15-147-00121-00-00

CONTRACTOR'S WELL LOG

OPERATOR D.G. Hansen--C-G Drilling Co. FARM NAME Fox #1
 LOCATION SE SE SE, Sec. 17-5-19W
 POOL NAME Wildcat COUNTY Phillips STATE Kansas
 COMMENCEMENT DATE July 30, 1954 COMPLETION DATE August 6, 1954

LOG OF WELL

Elevation: 2111' R.B.
 All measurements from the top of rotary bushing.

FROM	TO	FORMATION	DEVIATION FROM VERTICAL	REMARKS:
0	190	Sand-Shale		
190	800	Sand-Shale		
800	855	Sand		
855	1220	Shale		
1220	1435	Sand		
1435	1720	Red Bed	0° - 1500'	
1720	1758	Anhydrite		
1758	1800	Shale-Shells		
1800	2300	Shale-Shells	0° - 2000'	
2300	2500	Lime-Shale	0° - 2500'	
2500	2670	Lime-Shale		
2670	2885	Lime-Shale		
2885	3070	Lime-Shale	0° - 3000'	
3070	3180	Lime-Shale		
3180	3290	Lime-Shale		
3290	3375	Lime-Shale		
3375	3425	Lime-Shale		
3425	3431	Lime-Shale		DST 3401-31'
3431	3445	Lime-Shale		
3445	3545	Lime-Shale	0° - 3500'	
3545	3649	Lime-Shale		
3649	3695	Lime-Shale		

CASING LEFT IN HOLE AFTER COMPLETION

Ran 189.75' (6 jts) of 8-5/8" Surface Casing.

STATE OF KANSAS, COUNTY OF SEDGWICK) ss.

The undersigned certifies that to the best of her knowledge and belief, the above facts are true and correct.

C-G DRILLING CO.

By Vicky Jacobs
 Office Manager

Subscribed and sworn to before me this 10th day of August, 1954.

My commission expires: June 17, 1957

Barbara Donaldson
 Notary Public

RECEIVED
 STATE CORPORATION COMMISSION

AUG 11 1954
 08-11-1954
 CONSERVATION DIVISION
 Wichita, Kansas

PLUGGING
 FILE SEC 17-5-19W
 BOOK PAGE 55 LINE 14