

STATE OF KANSAS
STATE CORPORATION COMMISSION


WELL PLUGGING RECORD

Give All Information Completely
Make Required Affidavit
Mail or Deliver Report to
Conservation Division
State Corporation Comm.
245 North Water
Wichita, KS 67202

Phillips County. Sec. 2 Twp. 5 Rge. 20 E/W
Location as "NE/CNW/SW" or footage from lines SW-NW-SW

Lease Owner Bowman Oil Company
Lease James Hill "A" Well No. 1

Office Address P.O. Box 17 Codell, Ks. 67630
Character of Well (Completed as Oil, Gas or Dry Hole) Oil well

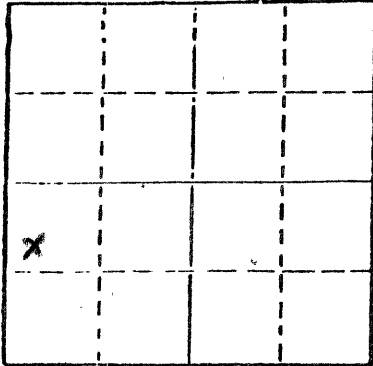

Date Well completed 4-11-51 19
Application for plugging filed 12-5-83 19
Application for plugging approved _____ 19
Plugging commenced 12-15-83 19
Plugging completed 12-15-83 19
Reason for abandonment of well or producing formation Oil depleted

If a producing well is abandoned, date of last production 6-1-82 19

Was permission obtained from the Conservation Division or its agents before plugging was commenced? YES

Name of Conservation Agent who supervised plugging of this well Dennis Hamel
Producing formation Aib Depth to top 3430 Bottom 3435 Total Depth of Well 3440
Show depth and thickness of all water, oil and gas formations.

OIL, GAS OR WATER RECORDS

CASING RECORD

FORMATION	CONTENT	FROM	TO	SIZE	PUT IN	PULLED OUT
<u>Arbuckle</u>	<u>oil & water</u>	<u>3430</u>	<u>3435</u>	<u>8"</u>	<u>193</u>	<u>NONE</u>
				<u>5"</u>	<u>3438</u>	<u>NONE</u>

Describe in detail the manner in which the well was plugged, indicating where the mud fluid was placed and the method or methods used in introducing it into the hold. If cement or other plugs were used, state the character of same and depth placed, from _____ feet to _____ feet for each plug set.

Cement 50/50 pop 870 gel.

5 1/2 casing pumped 25 sacks with hulls 7 sack of gel, 12.5 sacks of cement, 5 of gel, and 11.5 sacks of cement. Shut in at 450#.

8 5/8" Pumped 25 sack of cement with hulls at 450#.

(If additional description is necessary, use BACK of this sheet)

Name of Plugging Contractor Halliburton Services


STATE OF Kansas COUNTY OF Rooks, ss.
Louis D. Bowman (employee of owner) or (owner or operator)
of the above-described well, being first duly sworn on oath, says: That I have knowledge of the facts, statements, and matters herein contained and the log of the above-described well as filed and that the same are true and correct. So help me God.

(Signature) Louis D. Bowman
Box 37 Codell, Ks 67630
(Address)

SUBSCRIBED AND SWORN TO before me this 22 day of Dec, 19 83

Vesta J. Russell
Notary Public.

My commission expires July 17, 1984

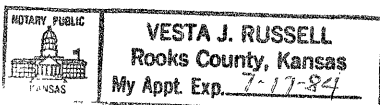

RECEIVED
STATE CORPORATION COMMISSION

JAN 12 1984

CONSERVATION DIVISION
Wichita, Kansas

1-12-84

Company: Helmerich & Payne, Inc.

SW NW SW

Farm: Perry Hill No. A-1

Section 2, Twp, 5S, Rge. 20W

Total Depth: 3440'

Phillips County,
Kansas

Comm: 3-30-51 Comp: 4-11-51

Elevation:

Contractor: Peel Brothers, Inc.

Production:

Casing: 8 5/8" - 193' 5 1/2" - 3438'

-Figures below indicate bottom formations -

Soil, clay & sand	0	40
Shale & shells		740
Red Bed		815
Anhydrite		830
Sand & shale		1220
Anhydrite		1240
Shale & shells		1545
Anhydrite		1582
Shale		1710
Shale & shells		1835
Lime, shale & shells		1870
Shale & lime strks.		2235
Shale & lime shells		2425
Lime		2835
Lime & shale		2985
Lime		3440
Total Depth		3440

Drilled with Cable Tools - 3448

3440 - 45 100'

3445 - 47 Be. Sand. Bed.

3447 - 48 in. shale.

Making 24 Bbls water per day, mostly fresh

	A-1	A-2
	3437	3424
ARB.	<u>2036</u>	<u>2015</u>
	- 1401	- 1409 ✓
	3448	3432 ✓
T.D.	<u>2036</u>	<u>2015</u>
	- 1412	- 1417

RECEIVED
STATE CONSERVATION COMMISSION

JAN 12 1954

CONSERVATION DIVISION
Wichita, Kansas