

15-147-00041-00-00

STATE OF KANSAS
STATE CORPORATION COMMISSION

WELL PLUGGING RECORD


Give All Information Completely
Make Required Affidavit
Mail or Deliver Report to:
Conservation Division
State Corporation Commission
800 Bitting Building
Wichita, Kansas

OR

FORMATION PLUGGING RECORD

Strike out upper line
when reporting plugging
off formations.

NORTH

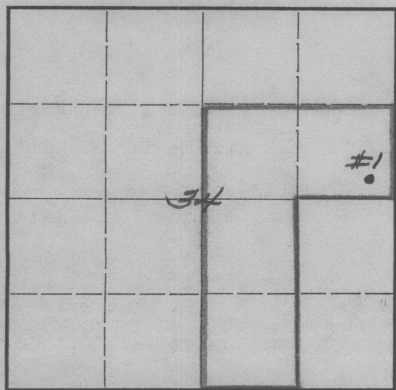

Locate well correctly on above
Section Plat

Phillips County. Sec. 34 Twp. 5S Rge. (E) 19 (W)
Location as "NE 1/4 NW 1/4 SW 1/4" or footage from lines SE 1/4 SE 1/4 NE 1/4
Lease Owner Skelly Oil Company
Lease Name Sarah C. Thayer Well No. 1
Office Address 210-11 Wolcott Building, Hutchinson, Ks.
Character of Well (completed as Oil, Gas or Dry Hole) Dry Hole
Date well completed January 23 19 45
Application for plugging filed January 29 19 45
Application for plugging approved February 2 19 45
Plugging commenced March 13 19 45
Plugging completed March 20 19 45
Reason for abandonment of well or producing formation Dry Hole

If a producing well is abandoned, date of last production 19
Was permission obtained from the Conservation Division or its agents before plugging was commenced? Yes

Name of Conservation Agent who supervised plugging of this well H. W. Kerr
Producing formation Depth to top Bottom Total Depth of Well Feet
Show depth and thickness of all water, oil and gas formations.


OIL, GAS OR WATER RECORDS

CASING RECORD

Formation	Content	From	To	Size	Put In	Pulled Out
Lansing Lime	Water	3195'	3480	8-5/8" OD	251' 3"	None
Arbuckle Lime	"	3480'	3503	5-1/2" OD	3509' 11"	2679' 0"

Describe in detail the manner in which the well was plugged, indicating where the mud fluid was placed and the method or methods used in introducing it into the hold. If cement or other plugs were used, state the character of same and depth placed, from feet to feet for each plug set.

75 sacks cement 3503' to 3398'
Mud laden fluid 3398' to 3150'
Wood plug and 2 sacks cement 3150' to 3130'
Mud laden fluid 3130' to 250'
Wood plug and 15 sacks cement 250' to 200'
Mud laden fluid 200' to 10'
Wood plug and 8 sacks cement 10' to 5'
Surface soil 5' to 0.

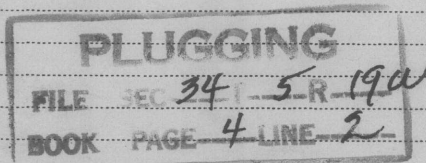

(If additional description is necessary, use BACK of this sheet)

Correspondence regarding this well should be addressed to Skelly Oil Company
Address Box 391, Hutchinson, Kansas


STATE OF KANSAS, COUNTY OF RENO
H. E. Wamsley

(employee of owner of ~~locus~~ ^{operator}) of the above-described well,
being first duly sworn on oath, says: That I have knowledge of the facts, statements, and matters herein contained and the log of the above-described well as filed and that the same are true and correct. So help me God.

(Signature)

Box 391, Hutchinson, Kansas


SUBSCRIBED AND SWORN to before me this 6th day of April 19 45

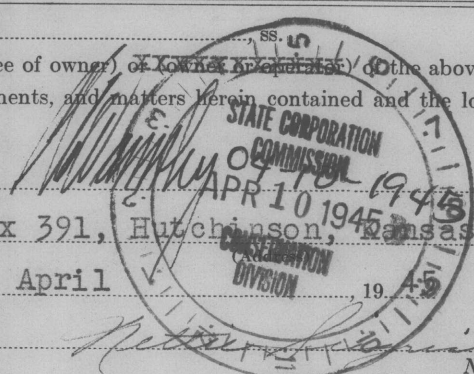

Notary Public.

My commission expires August 4, 1945.

15-147-00041-00-00
SKELLY OIL COMPANY

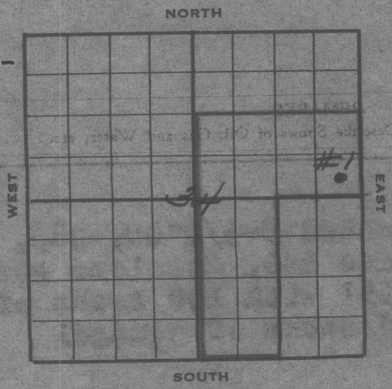

Well Record
#29139

Lease Name and No. **Barah C. Thayer** Well No. **1** Elev. **1982'**

Lease Description **8/2 NE/4 and W/2 SE/4**
Section 34-35-194, Phillips Co., Kansas

Location made **October 31** 19**44** by **Phillips Co. Engineer**
feet from North line **330** feet from East line **5/2 NE/4**
330 feet from South line feet from West line of **Sec. 34**

Work com'd **Nov. 7** 19**44** Rig comp'd **Nov. 12** 19**44** Drlg. com'd **Nov. 12** 19**44** Drlg. comp'd **Jan. 1**

Rig Contractor **Sterling Drilling Company**

Drilling Contractor **Sterling Drilling Company, Sterling, Kansas**

Rotary Drilling from **Top** to **3485'** Cable Tool Drilling from **3485'** to **3503'**

Commenced Producing **DRY HOLE** 19**44** { Initial Prod. before shot or acid
Initial Prod. after shot or acid **DRY HOLE**

Dry Gas Well Press _____ Volume _____

Casing Head Gas Pressure _____ Volume _____

Braden Head (_____ Size _____) Gas Pressure _____ Volume _____

Braden Head (_____ Size _____) Gas Pressure _____ Volume _____

PRODUCING FORMATION **DRY HOLE** (Name) Top Bottom TOTAL DEPTH **3503'**

CASING RECORD


Size	Wt.	Thds.	Where Set	PULLED OUT			LEFT IN			KIND	Cond'n	CEMENTING	
				Jts.	Feet	In.	Jts.	Feet	In.			Sacks Used	Method Employed
8-5/8" OD 28#	BR	255'					9	251	3	R2 H40 SB	A	100	Halliburton
5-1/2" OD 14#	BR	3481'	87	2679	0	28	830	11	R2 H40 RW	A	100	Halliburton	
(8-5/8" casing set 6' in collar)													
5 1/2" casing perforated: 47 holes from 3374-34'; 48 holes from 3320-36'; 24 holes from 3375-33'; 48 holes from 3257-77'; 36 holes from 3211-23'; 27 holes from 3238-54'; 35 holes from 3195-3207.													

Liner Set at _____ Length _____ Perforated at _____

Liner Set at _____ Length _____ Perforated at _____

Packer Set at _____ Size and Kind _____

Packer Set at _____ Size and Kind _____

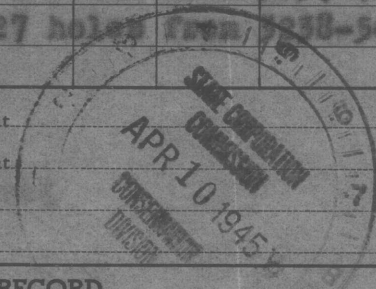

SHOT OR ACID TREATMENT RECORD

	FIRST	SECOND	THIRD	FOURTH
Date	January 8, 1945	January 10, 1945	January 13, 1945	
Acid Used				
Size Shot	1000	2500	750	
Shot Between	3374 Ft. and 3385 Ft.	3374 Ft. and 3384 Ft.	3320 Ft. and 3336 Ft.	Ft. and
Size of Shell				See body of 1
Put in by (Co.)	Dowell, Inc.	Dowell, Inc.		for further
Length anchor				acid treatment
Distance below Cas'g				
Damage to Casing or Casing Shoulder	None	None		

SIGNIFICANT GEOLOGICAL FORMATIONS

NAME	Top	Bottom	GAS		OIL		REMARKS
			From	To	From	To	
Leaning Line	3204'				3265'	3280'	slt. por. & sat.
Arbuckle Line	3480'				3485'	3485'	Por. w/ slt. sat. & odo

CLEANING OUT RECORDS

	DATE COMMENCED	DATE COMPLETED	PROD. BEFORE	PROD. AFTER	REMARKS
1st					See Reverse for other d
2nd					" " " "
3rd					" " " "
4th					" " " "

PLUGGING BACK AND DEEPENING RECORDS

	Date Commenced	Date Completed	No. Feet Plugged Back or Deepened	Prod. Before	Prod. After	REMARKS
1st						See Reverse for other d
2nd						" " " "
3rd						" " " "
4th						" " " "

(See Reverse for Record of Formation)

RECORD OF FORMATIONS

FORMATION	TOP	BOTTOM	REMARKS
Surface soil, shale & sand	0	180	Set and cemented 8-5/8" OD, 23 1/2' Range 2, Grade H40, stainless steel casing at 255' with 100 sacks of cement and 4 sacks of aquagel
shale and shells	180	255	
shale, sand & shells	255	600	
shale and sand	600	1000	
shells, shale & sand	1000	1340	
shale and shells	1340	1910	
shale	1910	2140	
shale	2140	2190	
shale & shale	2190	2485	
shale	2485	2540	
shale and shale	2540	2835	
shale	2835	2860	
shale	2860	2935	
shale	2935	2965	
shale	2965	3440	
shale	3440	3475	TOP LANSING LINE 3204'
shale and dark shale with weathered chert & sand	3475	3485	Little Lansing Line 3265-30'
shale and light brown dolomite	3485	3488	Slight porosity and saturation
shale and brown coarsely crystalline dolomite	3488	3490	slight stain
			Porous with slight saturation - oil odor
			Set and cemented 5 1/2" OD, 14 1/2' 8rd thd., Range 2, Grade H40, R.S.W. steel casing at 3481' SLM with 100 sacks of cement and 3 sacks of aquagel. Finished cementing at 6:00 AM November 27, 1944, and shut down waiting on cable tools. Moved in and rigged up cable tools and bailed the hole down on December 29, 1944, and 5 1/2" casing tested OK. Drilled cement plug and cement job tested OK. Correction: 3490' SLM rotary table equals 3485' SLM derrick floor
	3490	3485	Tested 2 hours, no shows



FORMATION	TOP	BOTTOM	REMARKS
shale and crystalline dolomite	3485	3488	Slight porosity and stain
			Tested 10 hours, 1/3 barrel water per hour, no oil
	3488	3499	Slight increase in water at 3499'
	3499	3503	Hole full of water from 3501'-3503'

On January 2, 1945, ran 2" tubing and cemented off Arbuckle line with 75 sacks of cement by Halliburton, then pulled tubing and shut down for cement to set. On January 6th bailed the hole dry and cement job tested OK. Top of cement plug at 3298'. Drilled cement plug to 3398', then on January 6th perforated 5 1/2" tubing by Lane-Wells with 47 holes from 3374-84', slight show of oil from 3380-82', perforated with 48 holes from 3320-36', no shows. Washed perforations with 2 barrels acid after which had some oil show up. Perforated with 24 holes from 3375-83' and on January 8th ran 2" tubing with Lane-Wells hook wall packer and set packer at 3368', then treated with 1000 gallons of Dowell "XP17" acid from 3374-84' as follows:

TREATMENT NO. 1 - Between 3374' and 3384'

Treatment put in January 8, 1945, by Dowell, Inc., using 1000 gallons acid and 92 barrels oil to fill hole and to flush:

TIME	GP	FP	REMARKS
0 PM	0	50	Hole filled with 78 barrels oil and started acid
5 PM	225	300	15 barrels acid in hole
2 PM	500	200	20 barrels acid in hole
6 PM	500	300	24 barrels acid in hole (1000 gallons)
0 PM	400	400	Hole flushed with 6 barrels oil
1 PM	400	550	Hole flushed with 14 barrels oil and treatment complete

After acid treatment, swabbed through 2" tubing 12 hours, 75 barrels of oil and acid water, then ran rods and FOB 12 hours, 25 barrels oil and no water and pumped off. On January 10th FOB 12 hours, 9 barrels oil and no water, then ran rods and reacidized with 2500 gallons of Dowell "XP" acid as follows:

TREATMENT NO. 2 - Between 3374' and 3384'

Treatment put in January 10, 1945, by Dowell, Inc., using 2500 gallons acid and 80 barrels oil to fill hole and to flush:

TIME	GP	FP	REMARKS
0 PM	0	50	Hole filled with 65 barrels oil and started acid
5 PM	350	250	17 barrels acid in hole
2 PM	400	300	36 barrels acid in hole
6 PM	400	250	60 barrels acid in hole
0 PM	400	500	Hole flushed with 15 barrels oil and treatment complete

After acid treatment, swabbed through 2" tubing 12 hours, 37 barrels oil and estimated 20 barrels acid water. Ran rods and FOB 12 hours, 10 barrels oil and 6 barrels water. Pulled rods and tubing with packer, then reran tubing and set packer at 3355' and treated with 750 gallons of Dowell "XF20" acid from 3320' to 3356' as follows:

ACID TREATMENT NO. 3 - Between 3320' and 3356'

Treatment put in January 15, 1945, by Dowell, Inc., using 750 gallons of Dowell acid and 80 barrels of oil to fill hole and to flush:

TIME	GP	TP	REMARKS
5:15PM		300'	Hole filled with 66 barrels oil and started acid
5:30PM	125'	0'	14 1/2 barrels acid in hole
5:35PM	175'	200'	18 barrels acid in hole and started oil flush
5:52PM	200'	250'	Hole flushed with 14 barrels oil and treatment complete

After acid treatment swabbed through 2" tubing 14 hours, 64 barrels oil and no water. Ran rods and on January 15th FOB 24 hours, 7 barrels oil and 6 barrels water.

On January 16th pulled rods and tubing, bailed hole dry, and on January 17th tested 6 hours, 30 gallons fluid per hour, 80% water. Perforated 5 1/2" casing with 48 holes from 3257-77', no shows; 36 holes from 3211-23', no shows, no increase in fluid; 27 holes from 3238-54', no shows; 35 holes from 3195' to 3207', no shows. On January 19th ran 2" tubing and treated with 1000 gallons of Dowell "XF20" acid from 3240-77' as follows:

ACID TREATMENT NO. 4 - Between 3240' and 3277'

Treatment put in January 19, 1945, by Dowell Acid Co., using 1000 gallons of Dowell acid and 100 barrels of oil to fill hole and to flush:

TIME	GP	TP	REMARKS
1:05 PM		150'	Hole filled with 84 barrels oil and started acid
1:15 PM	50'	0'	13 barrels acid in hole
1:25 PM	150'	250'	24 barrels acid in hole and started oil flush
1:41 PM	100'	175'	Hole flushed with 16 barrels oil and treatment complete

After acid treatment, swabbed through 2" tubing 24 hours, 74 barrels oil and 19 barrels water (oil used in treating). On January 21st ran rods and FOB 12 hours, 4 barrels oil and 36 barrels water.

On January 22nd pulled rods and set packer at 3229', then treated from 3195' to 3223' with 1000 gallons of Dowell "XF" acid as follows:

ACID TREATMENT NO. 5 - Between 3195' to 3223'

Treatment put in January 22, 1945, by Dowell, Inc., using 1000 gallons of Dowell acid and 74 barrels of oil to fill hole and to flush:

TIME	GP	TP	REMARKS
5:05 PM	50'	50'	Hole filled with 60 barrels oil and started acid
5:16 PM	200'	0'	13 barrels acid in hole
5:23 PM	Vac.	Vac.	24 barrels acid in hole and started oil flush
5:28 PM	Vac.	Vac.	Hole flushed with 14 barrels oil and treatment complete


After acid treatment, swabbed through 2" tubing 14 hours, 74 barrels fluid, 15% water, balance oil used in treatment. On January 23rd ran rods and FOB 24 hours, 72 barrels fluid, 98% water.

After this test regular authority was granted on January 26, 1945, to plug the well and abandon the location.

On March 15th General Oil Tool Company moved in and plugged the well as follows:

Cement plug		at 3398'
Mud laden fluid		3398' to 3150'
Wood plug and 2 sacks cement		3150' to 3130'
Mud laden fluid		3130' to 250'
Wood plug and 15 sacks of cement		250' to 200'
Mud laden fluid		200' to 10'
Wood plug and 8 sacks of cement		10' to 5'
Surface soil		5' to 0.

SLOPE TEST DATA	
DEPTH	ANGLE OF DEFLECTION
250'	0 Degrees
500'	0 "
750'	0 "
1000'	0 "
1250'	0 "
1500'	0 "
1750'	0 "
2000'	0 "
2250'	0 "
2500'	0 "
2750'	0 "
3000'	0 "
3250'	0 "

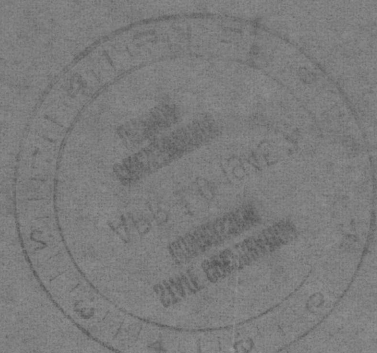

Faint, illegible text, possibly bleed-through from the reverse side of the page.


W. J. ...



PLUGGING
FILE # 345.19w
BOOK PAGE LINE 2
4