

KANSAS CORPORATION COMMISSION
OIL & GAS CONSERVATION DIVISION
WELL PLUGGING APPLICATION
Please TYPE Form and File ONE Copy

Form CP-1
September 2003
This Form must be Typed
Form must be Signed
All blanks must be Filled

API # 15 - 175-00039-00-02 (Identifier Number of this well). This must be listed for wells drilled since 1967; if no API # was issued, indicate original spud or completion date 12/13/50

Well Operator: Cabot Oil & Gas Corporation KCC License #: 6120
(Owner / Company Name) (Operator's)

Address: 600 17th Street, Ste. 900N City: Denver

State: Colorado Zip Code: 80202 Contact Phone: (303) 226 - 9443

Lease: L. C. Schmidt Well #: 1 (SWD) Sec. 26 Twp. 33 S. R. 34 East West

- C-S/2 - S/2 - NE Spot Location / QQQQ County: Seward

2970 Feet (in exact footage) From North / South (from nearest outside section corner) Line of Section (Not Lease Line)

1320 Feet (in exact footage) From East / West (from nearest outside section corner) Line of Section (Not Lease Line)

Check One: Oil Well Gas Well D&A Cathodic Water Supply Well

SWD Docket # D8467 ENHR Docket # _____ Other: _____

Conductor Casing Size: _____ Set at: _____ Cemented with: _____ Sacks

Surface Casing Size: 10-3/4" Set at: 574' Cemented with: 300 Sacks

Production Casing Size: 7" Set at: 2648' Cemented with: 650 Sacks

List (ALL) Perforations and Bridgeplug Sets: Glorietta: 1150'-70', Baker Mod. D pkr @ 913', CIBP @ 1,525'.

Elevation: 2,905' (G.L. / K.B.) T.D.: _____ PBDT: 1,525' Anhydrite Depth: Approx. 1,600'

(Stone Corral Formation)

Condition of Well: Good Poor Casing Leak Junk in Hole

Proposed Method of Plugging (attach a separate page if additional space is needed): As per KCC requirements.

RECEIVED
KANSAS CORPORATION COMMISSION

NOV 17 2004

Is Well Log attached to this application as required? Yes No Is ACO-1 filed? Yes No

CONSERVATION DIVISION
WICHITA, KS

If not explain why? Logs are not available.

Plugging of this Well will be done in accordance with K.S.A. 55-101 et. seq. and the Rules and Regulations of the State Corporation Commission.

List Name of Company Representative authorized to be in charge of plugging operations: Hadir Taki

Phone: (303) 226 - 9444

Address: 600 17th Street, Ste. 900N City / State: Denver, CO 80202

Plugging Contractor: Sargent & Horton Plugging, Inc. KCC License #: 31151

(Company Name)

(Contractor's)

Address: Route 1, Box 49BA, Tyrone, OK 73951 Phone: (580) 854 - 6515

Proposed Date and Hour of Plugging (if known?): 12-15-04

Payment of the Plugging Fee (K.A.R. 82-3-118) will be guaranteed by Operator or Agent

Date: 11-16-04 Authorized Operator / Agent: _____

Hadir Taki
(Signature)

Mail to: KCC - Conservation Division, 130 S. Market - Room 2078, Wichita, Kansas 67202

WELL DATA SHEET

Last Update: 10-8-07

Lease Name: L.C. Schmidt #1 SWD API No: _____

Location: 2970'S/1320'E C-5/2-S/2-NE, Sec 26, T-33S, R-34W County: Seward ST: KS

Spud Date: _____ Well Elev: _____ GL _____ KB

TD Date: _____ Completion Date: _____

TD: _____ PBTD: 1525' TOC: ?

Casing Producing Formation: Glorieta

Size: 10 3/4" Perfs: From 1150' to 70' /spf _____ to _____


Wt: _____ to _____ /spf _____ to _____

Grd: _____ IP: _____ BOPD _____ BWPD _____ MCF/D

Dpth: 574' Well History: ? Inj Permit: 500 BPP & 500 PSI

Cmt: ? sx (Circ)

8-28-07: MET 3307310 psi in 30 min. Percol

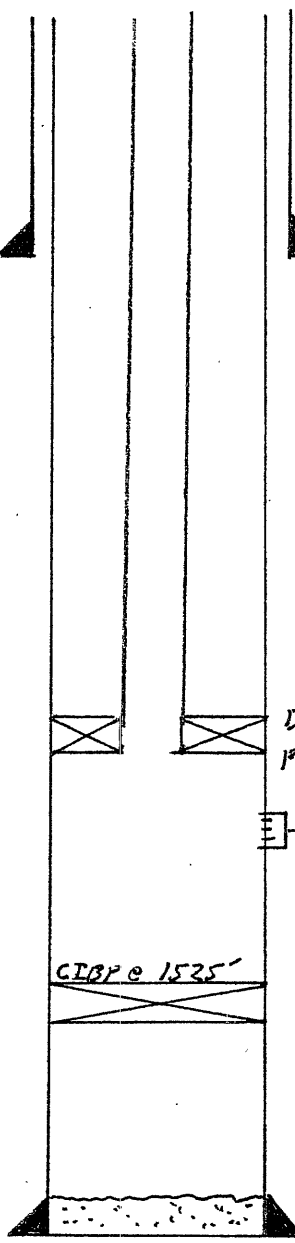

Baker Mod. D
10KR @ 913'

1150-70'

CIBP @ 1525'

RECEIVED
KANSAS CORPORATION COMMISSION

NOV 17 2004

CONSERVATION DIVISION
WICHITA, KS

Well Equipment:

Pumping Unit: _____

Size: 7" Motor Type: _____ HP: _____ POC: _____

Wt: _____ Tbg: ? Jts 2 3/8" Size Fiberglass Grade

Grd: _____ MA @ _____ SN @ 913' TAC @ _____

Dpth: ? Rods: _____

Cmt: ? Pump: _____

KANSAS

CORPORATION COMMISSION

Kathleen Sebelius, Governor Brian J. Moline, Chair Robert E. Krehbiel, Commissioner Michael C. Moffet, Commissioner

NOTICE OF RECEIPT OF WELL PLUGGING APPLICATION (CP-1)

Cabot Oil & Gas Corporation
600 17th St., Suite 900 North
Denver, CO 80202

November 17, 2004

Re: L C SCHMITT #1
API 15-175-00039-00-02
S2S2NE 26-33S-34W, 2970 FSL 1320 FEL
SEWARD COUNTY, KANSAS

Dear Operator:

This letter is to notify you that the Conservation Division is in receipt of your plugging proposal, form CP-1, for the above-captioned well.

Your CP-1 has been reviewed by the Conservation Division central office for completeness and to verify license numbers. The plugging proposal will now be forwarded to the district office listed below for review of your proposed method of plugging.

Please contact the district office for approval of your proposed plugging method at least five (5) days before plugging the well, pursuant to K.A.R. 82-3-113 (b). If a workover pit will be used during the plugging of the well it must be permitted. A CDP-1 form must be filed and approved prior to the use of the pit.

The Conservation Division's review of form CP-1, either in the central or district office, does not include an inquiry into well ownership or the filing operator's legal right to plug the well.

This notice in no way constitutes authorization to plug the above-captioned well by persons not having legal rights of ownership or interest in the well. This notice is void after ninety (90) days from the above date.

Sincerely



David P. Williams
Production Supervisor

District: #1
210 E Frontview, Suite A
Dodge City, KS 67801
(620) 225-8888