


Give All Information Completely
Make Required Affidavit
Mail or Deliver Report to:
Conservation Division
State Corporation Commission
211 No. Broadway
Wichita, Kansas

WELL PLUGGING RECORD

15-147-19011-0000

NORTH

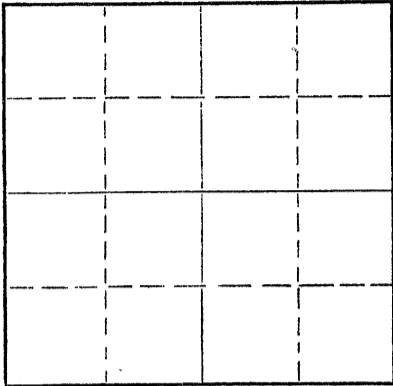

Locate well correctly on above
Section Plat

Phillips County. Sec. 3 Twp. 5 Rge. 20 (E) (W)
Location as "NE/CNW/SW" or footage from lines NE SE SE
Lease Owner Bankoff Oil Company
Lease Name Perry Well No. 3
Office Address P. O. Box 2479, Tulsa, Oklahoma
Character of Well (completed as Oil, Gas or Dry Hole) Dry Hole
Date well completed 11-2-64 19
Application for plugging filed 11-2-64 19
Application for plugging approved 11-2-64 19
Plugging commenced 11-2-64 19
Plugging completed 11-2-64 19
Reason for abandonment of well or producing formation Dry Hole

If a producing well is abandoned, date of last production 19
Was permission obtained from the Conservation Division or its agents before plugging was commenced? yes

Name of Conservation Agent who supervised plugging of this well Eldon Petty, Hays, Kansas
Producing formation Depth to top Bottom Total Depth of Well 3460 Feet
Show depth and thickness of all water, oil and gas formations.

OIL, GAS OR WATER RECORDS

CASING RECORD

FORMATION	CONTENT	FROM	TO	SIZE	PUT IN	PULLED OUT
				8 5/8"	210'	none

Describe in detail the manner in which the well was plugged, indicating where the mud fluid was placed and the method or methods used in introducing it into the hole. If cement or other plugs were used, state the character of same and depth placed, from feet to feet for each plug set.

1st Plug @ 540' with 1/4 sk. hulls 20 sks. cement
2nd Plug @ 200' with 1/4 sk. hulls 20 sks. cement
3rd Plug @ 35' with 1/4 sk. hulls 10 sks. cement

RECEIVED
STATE CORPORATION COMMISSION

NOV 5 1964

CONSERVATION DIVISION
Wichita, Kansas

(If additional description is necessary, use BACK of this sheet)

Name of Plugging Contractor Leben Drilling, Inc.
Address P. O. Box 486, Great Bend, Kansas

11-5-64

STATE OF KANSAS, COUNTY OF BARTON, ss.
Leslie Kite

(employee of owner) or (owner or operator) of the above-described well, being first duly sworn on oath, says: That I have knowledge of the facts, statements, and matters herein contained and the log of the above-described well as filed and that the same are true and correct. So help me God.

(Signature) Leslie Kite
P. O. Box 486, Great Bend, Kansas
(Address)

SUBSCRIBED AND SWORN TO before me this 3rd day of November, 1964

Mauda S. ...
Notary Public.

My commission expires April 1, 1967

DRILLER'S LOG

COMPANY: Bankoff Oil Company
 CONTRACTOR: LEBEN DRILLING, INC.
 FARM: PERRY #3
 LOCATION: NE SE SE Sec. 3-5-20
 PHILLIPS COUNTY, KANSAS
 COMMENCED: 10-28-64
 COMPLETED: 11-2-64
 15-147-19011-0000

0	210	Shale
210	925	Shale & Sand
925	1530	Shale & Shells
1530	1555	Anhydrite
1555	2160	Shale
2160	2500	Shale & Lime
2500	2710	Lime & Shale
2710	2983	Shale & Lime
2983	3460	Lime
	<u>3460</u>	<u>Rotary Total Depth - D. & A.</u>

Set 8 5/8" used casing @ 210' with 165 sacks Sunset

I, Leslie Kite, do hereby certify that the above and foregoing is a true and correct copy of the log of the Perry #3 well, located NE SE SE of Section 3, Township 5, Range 20, Phillips County, Kansas, as reflected by the files of Leben Drilling, Inc.

Leslie Kite

Leslie Kite

STATE OF KANSAS)
) SS
 COUNTY OF BARTON)

Subscribed and sworn to before me, a Notary Public, in and for Barton County, Kansas, this 3rd day of November, 1964.

Ulanda Nichols

Ulanda Nichols

My Commission Expires
 April 1, 1967

RECEIVED
 STATE CORPORATION COMMISSION

NOV 5 1964

CONSERVATION DIVISION
 Wichita, Kansas