


STATE OF KANSAS
STATE CORPORATION COMMISSION

Give All Information Completely
Make Required Affidavit
Mail or Deliver Report to:
Conservation Division
State Corporation Commission
800 Bittling Building
Wichita, Kansas

WELL PLUGGING RECORD

15-147-00856-0000

NORTH

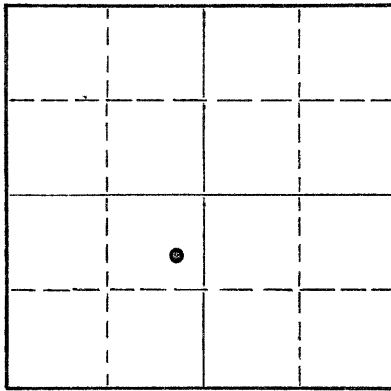

Locate well correctly on above
Section Plat

Phillips County, Sec. 3 Twp. 5 Rge. 20 (X) W (W)

Location as "NE/CNW/SW" or footage from lines SE NE SW
Lease Owner White Eagle Oil Company
Lease Name Bowman "A" Well No. 2
Office Address Box 255; Garden City, Kansas
Character of Well (completed as Oil, Gas or Dry Hole) Oil
Date well completed 5/27 1947
Application for plugging filed 10/22 1958
Application for plugging approved 10/23 1958
Plugging commenced 11/30 1958
Plugging completed 12/2 1958
Reason for abandonment of well or producing formation Well depletion.

If a producing well is abandoned, date of last production 4/29 1958
Was permission obtained from the Conservation Division or its agents before plugging was commenced? Yes

Name of Conservation Agent who supervised plugging of this well Mr. Eldon Petty
Producing formation Arbuckle Depth to top 3406 Bottom 3420 Total Depth of Well 3420 Feet
Show depth and thickness of all water, oil and gas formations.

OIL, GAS OR WATER RECORDS

CASING RECORD

FORMATION	CONTENT	FROM	TO	SIZE	PUT IN	PULLED OUT
Arbuckle	Oil	3406	T.D.	10 3/4	157	None
				5 1/2	3406	1410

Describe in detail the manner in which the well was plugged, indicating where the mud fluid was placed and the method or methods used in introducing it into the hole. If cement or other plugs were used, state the character of same and depth placed, from _____ feet to _____ feet for each plug set.

Plugged back with sand from 3420' to 3390'. Dumped 4 sx. cement. Pulled casing to 600'. Circulated w/25 sx. gel mud and spotted 20 sx. cement thru casing. Pulled casing to 140' and spotted 20 sx. cement. Pulled remainder of casing. Set 10' rock bridge from 30' to 20' and dumped 10 sx. cement to base of cellar.

RECEIVED
STATE CORPORATION COMMISSION
DEC 11 1958
CONSERVATION DIVISION
Wichita, Kansas

(If additional description is necessary, use BACK of this sheet)
Name of Plugging Contractor Ace Pipe Pulling Company 12-11-58
Address Great Bend, Kansas

STATE OF KANSAS, COUNTY OF FINNEY, ss.
N. E. CLARK (employee of owner) or (owner or operator) of the above-described well, being first duly sworn, says: That I have knowledge of the facts, statements, and matters herein contained and the log of the above-described well as filed and that the same are true and correct. So help me God.

(Signature) N. E. Clark
Box 255; Garden City, Kansas
(Address)

SUBSCRIBED AND SWORN to before me this 10 day of December, 1958

My commission expires 11/29/60

Russell Welch
Notary Public.

PLUGGING
FILE SEC 3 T 5 R 20W
BOOK PAGE 138 LINE 10

WELL LOG BUREAU KANSAS GEOLOGICAL SOCIETY
412 Union National Bk. Bldg., Wichita, Kansas


COPY

Company - TIDE WATER ASSOC. OIL CO. & REELERIGH &
Farm Bowman "1." No. 2. PLYME, INC.

SEC. 3 T. 5 R. 20 W
SE NE SW

Total Depth. 3420
Comm. 4-27-46 Comp. 5-27-46
Shot or Treated.
Contractor.
Issued. 7-6-46

County. Phillips
KANSAS

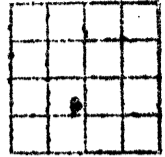

CASING:
10 3/4" 157' Cem.
5 1/2" 3406' Cem.

Elevation. _____

Production. Phy. Pot. 90 B

Figures indicate Bottom of Formations.

15-147-00856-0000

surface clay & shale	190
shale, sand & shells	1260
sand & shale, lime	1530
anhydrite	1555
red rock & shale	1340
anhydrite & shale	1940
shale & shells	2115
shale, sand & shells	2350
shale & lime	2440
shale	2525
lime & shale	2635
shale sdy & shells	2735
shale & shells	2800
shale & sand	2878
shale & lime	3014
lime	3039
lime & shale	3144
lime	3229
lime & shale	3409
lime	3420
Total Depth	

Tops:

Topoka	2892
Heebner shale	3089
Iansing-Kans. City	3114
Base Kans. City	3330
Arbuckle	3406