


WELL PLUGGING RECORD

15-147-00573-0000

Phillips County, Sec. 3 Twp. 5 Rge. 20 (E) (W) X

Location as "NE/CNW/SE" or footage from lines SE NE SE
 Lease Owner Bankoff Oil Co.
 Lease Name Brown Well No. #3
 Office Address P.O. Box 2479 Tulsa, Oklahoma
 Character of Well (completed as Oil, Gas or Dry Hole) _____
 Date well completed _____ 19____
 Application for plugging filed 10-3-75 19____
 Application for plugging approved _____ 19____
 Plugging commenced 10-9-75 19____
 Plugging completed 10-15-75 19____
 Reason for abandonment of well or producing formation _____

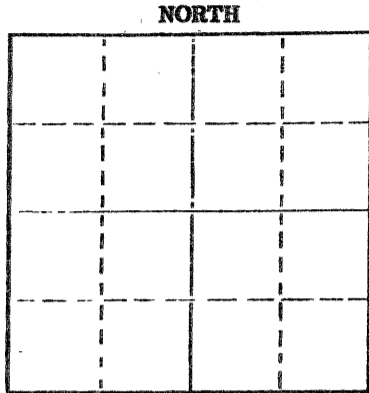

Locate well correctly on above Section Plat

If a producing well is abandoned, date of last production _____ 19____
 Was permission obtained from the Conservation Division or its agents before plugging was commenced? _____

Name of Conservation Agent who supervised plugging of this well Leo Massey
 Producing formation _____ Depth to top _____ Bottom _____ Total Depth of Well 3285' Feet
 Show depth and thickness of all water, oil and gas formations.

OIL, GAS OR WATER RECORDS

CASING RECORD

FORMATION	CONTENT	FROM	TO	SIZE	PUT IN	PULLED OUT
				5 1/2"	3283'	2215.14'
				10 3/4"	217'	

Describe in detail the manner in which the well was plugged, indicating where the mud fluid was placed and the method or methods used in introducing it into the hole. If cement or other plugs were used, state the character of same and depth placed, from _____ feet to _____ feet for each plug set.

Made bottom hole plug back with sand to 3175'. Mixed and ran 4 sacks cement thru dump bailer.
 Squeezed hole with 5 sacks hulls - 20 sacks gel - 70 sacks cement and 15 sacks gel. Released plug and displaced with 70 sacks cement to base of cellar.


(If additional description is necessary, use BACK of this sheet)
 Name of Plugging Contractor Southwest Casing Pulling Co.
 Address Box 364 Great Bend, Kansas

STATE OF Kansas COUNTY OF Barton, ss.
Southwest Casing Pulling Co. (employee of owner) or (owner or operator) of the above-described well, being first duly sworn on oath, says: That I have knowledge of the facts, statements, and matters herein contained and the log of the above-described well as filed and that the same are true and correct. So help me God.

(Signature) W. C. Spencer Sec.
Box 364 Great Bend, Kansas
 (Address)

SUBSCRIBED AND SWORN to before me this 16 day of October, 1975

My commission expires 24 October 1976
Sidney D. Miller
 Notary Public.

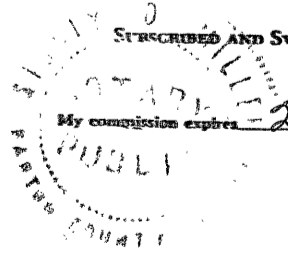

PHILLIPS

LOG

Company: White Eagle Oil Company

Farm: Brown Well No. 3
Comm: 10-3-52 Comp: 10-14-52

Total Depth: 3285'
Contractor: Peal Brothers, Inc.

Casing: 10-3/4" @ 217' cem.
5-1/2" @ 3283' cem.

15-147-00573-000
Sec. 3, Twp. 53, Rge. 20W,
County: Phillips,
Kansas

Elevation:

Production:

Figures below indicate bottom of formations

Sandy Clay	0'	25
Sand		65
Shale and Sand Streaks		217
Shells, Shale and Sand		516
Shale and Sand Streaks		575
Shale and Shells		775
Red Bed and Shells		1140
Sand		1275
Shale and Sand Streaks		1400
Red Bed and Shale		1540
Anhydrite		1570
Shale and Red Bed		1680
Shale and Shells		2170
Shale and Lime Streaks		2820
Shale and Lime		2955
Shale and Lime Streaks		2985
Lime		3285
Total Depth		3285

RECEIVED
STATE OCCUPATION COMMISSION

OCT 6 1975

CONSERVATION DIVISION
Wichita, Kansas

10-6-75

This is to certify that the above information is to the best of my knowledge true and correct.

PEAL BROTHERS, INC.,

BY: *E. E. Lutter*

SUBSCRIBED AND SWORN to before me this 15th day of October, 1952.

Bernice L. Jensen
Notary Public - Barton County, Mo.

My commission expires April 23, 1955.