

STATE OF KANSAS  
STATE CORPORATION COMMISSION


WELL PLUGGING RECORD

15-147-00572 -0000

Give All Information Completely  
Make Required Affidavit  
Mail or Deliver Report to  
Conservation Division  
State Corporation Comm.  
245 North Water  
Wichita, KS 67202

Phillips County, Sec. 3 Twp. 5S Rge. 20W E/W  
Location as "NE/CNW $\frac{1}{4}$ /SW $\frac{1}{4}$ " or footage from lines  
~~NE SW SW~~ SW SW NE

Lease Owner Bankoff Oil Company  
Lease Name Brown #2 Well No. \_\_\_\_\_  
Office Address Great Bend, Kansas 67530  
Character of Well (Completed as Oil, Gas or Dry Hole) \_\_\_\_\_

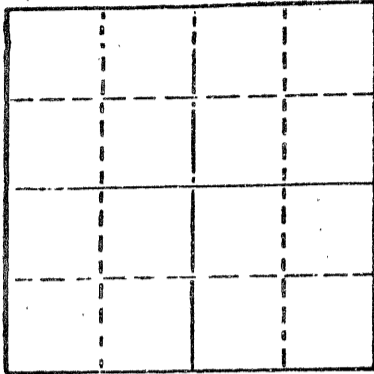

Locate well correctly on above  
Section Plat

Date Well completed \_\_\_\_\_ 19\_\_\_\_  
Application for plugging filed \_\_\_\_\_ 19\_\_\_\_  
Application for plugging approved \_\_\_\_\_ 19\_\_\_\_  
Plugging commenced 6/22/77 \_\_\_\_\_ 19\_\_\_\_  
Plugging completed 6/24/77 \_\_\_\_\_ 19\_\_\_\_  
Reason for abandonment of well or producing formation  
depleted. \_\_\_\_\_

If a producing well is abandoned, date of last production  
\_\_\_\_\_ 19\_\_\_\_

Was permission obtained from the Conservation Division or  
its agents before plugging was commenced? yes

Name of Conservation Agent who supervised plugging of this well Massey  
Producing formation \_\_\_\_\_ Depth to top \_\_\_\_\_ Bottom \_\_\_\_\_ Total Depth of Well 3385  
Show depth and thickness of all water, oil and gas formations.

OIL, GAS OR WATER RECORDS

CASING RECORD

FORMATION	CONTENT	FROM	TO	SIZE	PUT IN	PULLED OUT
				8-5/8	180	none
				5 1/2"	3384	710'

Describe in detail the manner in which the well was plugged, indicating where the mud fluid  
was placed and the method or methods used in introducing it into the hold. If cement or other  
plugs were used, state the character of same and depth placed, from \_\_\_\_\_ feet to  
\_\_\_\_\_ feet for each plug set.

Pushed wood plug to top of tubing, 1290'. Ran 10' sand and 5 sacks cement.  
Shot pipe at 1194', 1104', 1014', 918', 818', 710', pulled 23 joints.  
Pumped 20 sacks gel, 75 sacks cement, 10 sacks gel and 2 sacks hulls, 75 sacks  
cement.

PLUGGING COMPLETE.

RECEIVED  
STATE CORPORATION COMMISSION  
WICHITA, KANSAS

JUN 29 1977

(If additional description is necessary, use BACK of this sheet)

Name of Plugging Contractor KELSO CASTING PULLING  
CHASE, KANSAS

6-29-77

STATE OF KANSAS COUNTY OF RICE ss.

R. DARRELL KELSO (employee of owner) or (owner or operator) of the above-described  
well, being first duly sworn on oath, says: That I have knowledge of the facts, statements, and matters herein contained and the log of the  
above-described well as filed and that the same are true and correct. So help me God.

(Signature) R. Darrell Kelso

CHASE, KANSAS  
(Address)

SUBSCRIBED AND SWORN TO before me this 27th day of June, 19 77

Margaret Melcher  
Notary Public.

My commission expires \_\_\_\_\_

