

15-147-00697-00-00

WELL PLUGGING RECORD

FORMATION PLUGGING RECORD

STATE OF KANSAS STATE CORPORATION COMMISSION

Give All Information Completely Make Required Affidavit Mail or Deliver Report to: Conservation Division State Corporation Commission 800 Bitting Building Wichita, Kansas

Strike out upper line when reporting plugging off formations.

OR

Phillips County, Sec. 11 Twp. 5 Rge. 20 (E) (W)

Location as "NE 1/4 NW 1/4 SW 1/4" or footage from lines SE SE NE

Lease Owner Westgate-Greenland Oil Co and Mallard Drilling Company

Lease Name Ross Well No. 1

Office Address 1022 Union National Bank Building, Wichita 2, Kansas

Character of Well (completed as Oil, Gas or Dry Hole) dry hole

Date well completed July 24, 1947 19

Application for plugging filed July 24, 1947 19

Application for plugging approved July 24, 1947 19


Plugging commenced July 24, 1947 19

Plugging completed July 24, 1947 19

Reason for abandonment of well or producing formation dry hole

If a producing well is abandoned, date of last production 19

Was permission obtained from the Conservation Division or its agents before plugging was commenced? yes

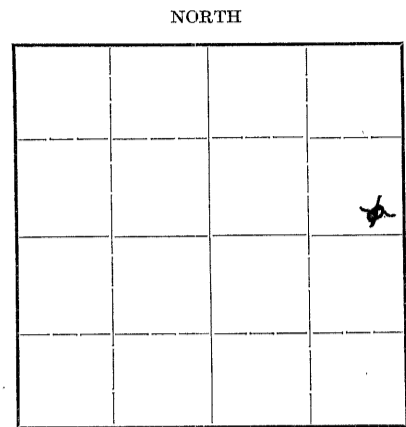

Locate well correctly on above Section Plat

Name of Conservation Agent who supervised plugging of this well C. D. Stough

Producing formation Depth to top Bottom Total Depth of Well Feet

Show depth and thickness of all water, oil and gas formations.

OIL, GAS OR WATER RECORDS

CASING RECORD

Table with 7 columns: Formation, Content, From, To, Size, Put In, Pulled Out. Row 1: Surface, 0, 155, 8 5/8", 155, none.

Describe in detail the manner in which the well was plugged, indicating where the mud fluid was placed and the method or methods used in introducing it into the hole.

Filled hole with heavy mud Set plug 155 feet and cemented with 15 sacks cement 155' to 120' Filled with heavy mud to 20' and cemented with 10 sacks of cement Filled with heavy mud to cellar base.

Handwritten notes and stamps including '7-31-47'.

(If additional description is necessary, use BACK of this sheet)

Correspondence regarding this well should be addressed to G. E. Bitler, 1022 Union National Bank Building Address Wichita 2, Kansas

STATE OF Kansas, COUNTY OF Sedgwick, ss. G. E. Bitler (employee of owner) or (contractor) of the above-described well, being first duly sworn on oath, says: That I have knowledge of the facts, statements, and matters herein contained and the log of the above-described well as filed and that the same are true and correct. So help me God.

(Signature) G. E. Bitler 1022 Union National Bk Bldg, Wichita 2, Kansas (Address)

SUBSCRIBED AND SWORN TO before me this 29th day of July, 1947. Esther Wells Notary Public.

My commission expires May 25, 1949



PLUGGING FILE SEC 11 T 5 R 20 W BOOK PAGE 122 LINE 22