


15-147-00699-0000

STATE OF KANSAS  
STATE CORPORATION COMMISSION

WELL PLUGGING RECORD

Give All Information Completely  
Make Required Affidavit  
Mail or Deliver Report to:  
Conservation Division  
State Corporation Commission  
800 Bitting Building  
Wichita, Kansas

Phillips County. Sec. 14 Twp. 5 Rge. 20W (E) (W)  
Location as "NE/CNW $\frac{1}{4}$ SW $\frac{1}{4}$ " or footage from lines SW NE SE  
Lease Owner Laura Jane Oil Co., Inc.  
Lease Name Andrews Well No. 1  
Office Address 504 Fourth Nat'l Bank, Wichita, Kans  
Character of Well (completed as Oil, Gas or Dry Hole) dry hole  
Date well completed September 15 19 50  
Application for plugging filed September 15 19 50  
Application for plugging approved September 15 19 50  
Plugging commenced September 16 19 50  
Plugging completed September 16 19 50  
Reason for abandonment of well or producing formation dry hole

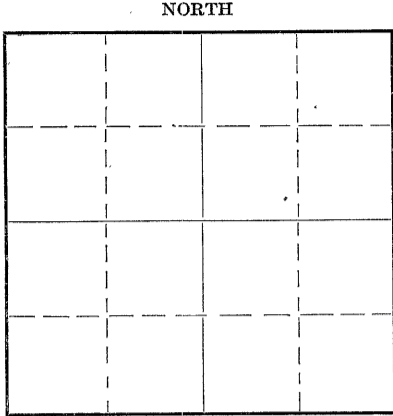

Locate well correctly on above  
Section Plat

If a producing well is abandoned, date of last production 19  
Was permission obtained from the Conservation Division or its agents before plugging was com-  
menced? yes

Name of Conservation Agent who supervised plugging of this well ?  
Producing formation none Depth to top Bottom Total Depth of Well 3583 Feet  
Show depth and thickness of all water, oil and gas formations.

OIL, GAS OR WATER RECORDS

CASING RECORD

Formation	Content	From	To	Size	Put In	Pulled Out
				8 5/8 OD	205	none

Describe in detail the manner in which the well was plugged, indicating where the mud fluid was placed and the method or methods used in introducing it into the hole. If cement or other plugs were used, state the character of same and depth placed, from feet to feet for each plug set.

First plug set @ 200' w/15 sacks cement on top hole filled to within 35' w/ heavy mud  
Plug set and cemented w/ 10 sacks cement

RECEIVED  
Conservation Div.  
SEP 21 1950  
STATE CORPORATION  
COMMISSION  
KANSAS

9-21-50

(If additional description is necessary, use BACK of this sheet)  
Correspondence regarding this well should be addressed to Laura Jane Oil Co., Inc.  
Address 504 Fourth Nat'l Bank, Wichita, Kansas

STATE OF Kansas, COUNTY OF Sedgwick, ss.  
H. D. Shawver (employee of owner) or (owner or operator) of the above-described well,  
being first duly sworn on oath, says: That I have knowledge of the facts, statements, and matters herein contained and the log of the above-described well as filed and that the same are true and correct. So help me God.

(Signature) H. D. Shawver

(Address)

SUBSCRIBED AND SWORN to before me this 19th day of September, 19 50.

My commission expires Notary Public.

PLUGGING  
SEE SEC. 14 T. 5 R. 20W  
PAGE 28 LINE 13