

STATE OF KANSAS
STATE CORPORATION COMMISSION

WELL PLUGGING RECORD

Give All Information Completely
Make Required Affidavit
Mail or Deliver Report to:
Conservation Division
State Corporation Commission
211 No. Broadway
Wichita, Kansas

Russell County. Sec. 11 Twp. 5 Rge. 20 (E) (W)

Location as "NE/CNW/SW" or footage from lines C SW NE SW

Lease Owner Helmerich & Payne, Inc.

Lease Name Baird Well No. 1

Office Address Box 558, Garden City, Kansas

Character of Well (completed as Oil, Gas or Dry Hole) Dry Hole

Date well completed 11-26-65 19

Application for plugging filed 11-26-65 19

Application for plugging approved 11-26-65 19

Plugging commenced 11-26-65 19


Plugging completed 11-26-65 19

Reason for abandonment of well or producing formation Dry Hole

If a producing well is abandoned, date of last production _____ 19

Was permission obtained from the Conservation Division or its agents before plugging was commenced? Yes

NORTH

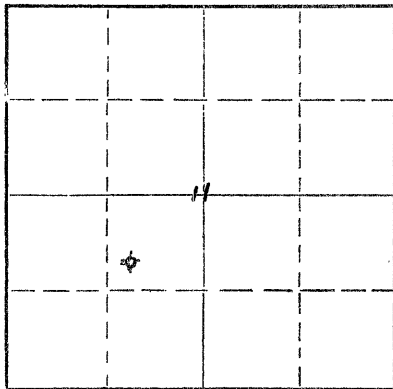

Locate well correctly on above Section Plat

Name of Conservation Agent who supervised plugging of this well Mr. Liker Victoria, Kansas

Producing formation _____ Depth to top _____ Bottom _____ Total Depth of Well 3575 Feet

Show depth and thickness of all water, oil and gas formations.

OIL, GAS OR WATER RECORDS

CASING RECORD

FORMATION	CONTENT	FROM	TO	SIZE	PUT IN	PULLED OUT
	8-5/8"	4'	224	8-5/8"	224	None

Describe in detail the manner in which the well was plugged, indicating where the mud fluid was placed and the method or methods used in introducing it into the hole. If cement or other plugs were used, state the character of same and depth placed, from _____ feet to _____ feet for each plug set.

3575' to 540' Plug & Heavy Rotary Mud
540' to 480' Plug & 20 sacks cement
480' to 210' Heavy Rotary Mud
210' to 150' Plug & 20 sacks cement
150' to 40' Heavy Rotary Mud
40' to 4' 1/2 sack hulls & 10 sacks cement
4' to 0 Cellar

Plugging completed: 11-26-65

RECEIVED
STATE CORPORATION COMMISSION

NOV 30 1965

CONSERVATION DIVISION
Wichita, Kansas

Name of Plugging Contractor Murfin Drilling Co. (If additional description is necessary, use BACK of this sheet)
Address Union Center, Wichita, Kansas 11-30-65

STATE OF Kansas, COUNTY OF Finney, ss. C. A. Richter

(employee of owner) or (owner or operator) of the above-described well, being first duly sworn on oath, says: That I have knowledge of the facts, statements, and matters herein contained and the log of the above-described well as filed and that the same are true and correct. So help me God.

(Signature) C. A. Richter

Box 558, Garden City, Kansas
(Address)

SUBSCRIBED AND SWORN to before me this 26 day of November, 19 65

My commission expires July 1968

Notary Public.


Robert N. Boyd
Robert N. Boyd

WELL LOG 15-147-30102-00-00

COMPANY Helmerich & Payne, Inc.
FARM BAIRD NO. 1
RIG. NO. 11
TOTAL DEPTH 3575'
COMM. 11-18-65 COMP. 11-26-65
SHOT OR TREATED
CONTRACTOR Murfin Drilling Company
ISSUED

SEC. 11 T. 5S R. 20W
LOC. C SW NE SW

COUNTRY Phillips
KANSAS

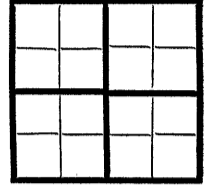

CASING
20 10
15 8 5/8" 224' w/225 sacks
12 6
13 5

ELEVATION
PRODUCTION D&A

FIGURES INDICATE BOTTOM OF FORMATIONS

- 225 Post Rock & Shale
- 452 Blue Shale
- 1235 Shale, Shells & Sand
- 1345 Sand
- 1609 Shale & Red Bed
- 1645 Anhydrite
- 2070 Shale
- 2474 Shale & Lime
- 2965 Lime & Shale
- 3055 Lime
- 3120 Lime, Shale & Chert
- 3575 Lime
- 3575 RTD

RECEIVED
STATE CORPORATIONS COMMISSION
DEC 13 1965
CONSERVATION DIVISION
12-13-65
TOPEKA, KANSAS

State of KANSAS
County of SEDGWICK } ss:

I, C. Robert Buford of the Murfin Drilling Company

upon oath state that the above and foregoing is a true and correct copy of the log of the BAIRD #1 well.

MURFIN DRILLING COMPANY
By: C. Robert Buford
C. Robert Buford

Subscribed and sworn to before me this 1st day of December 1965

My Commission Expires: ADELA MIZENER, Notary Public
My commission expires November 5, 1966

Adela Mizener
NOTARY PUBLIC