

15-147-20402-00-00


STATE OF KANSAS
STATE CORPORATION COMMISSION

Form CP-4

Give All Information Completely
Make Required Affidavit
Mail or Deliver Report to:
Conservation Division
State Corporation Commission
212 No. Market
Wichita, Kansas

WELL PLUGGING RECORD

Phillips County, Sec. 11 Twp. 5 Rge. 20 (E) (W)
Location as "NE/CNW/SW" or footage from lines NW NW SE S2 SWS E
Lease Owner Ozark Enterprises
Lease Name Rundle Well No. 2
Office Address Box 427 Logan, Ks. 67646
Character of Well (completed as Oil, Gas or Dry Hole) Dry Hole
Date well completed 12-14 1982
Application for plugging filed 12-14 1982
Application for plugging approved 12-14 1982
Plugging commenced 12-14 1982
Plugging completed 12-14 1982
Reason for abandonment of well or producing formation Dry Hole

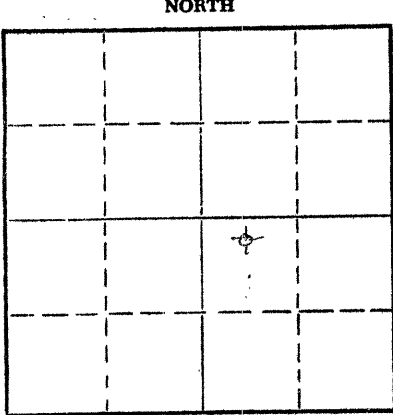

Locate well correctly on above Section Plat

If a producing well is abandoned, date of last production 19
Was permission obtained from the Conservation Division or its agents before plugging was commenced? Yes

Name of Conservation Agent who supervised plugging of this well Gilbert Balthazor
Producing formation _____ Depth to top _____ Bottom _____ Total Depth of Well 3370' Feet
Show depth and thickness of all water, oil and gas formations.

OIL, GAS OR WATER RECORDS

CASING RECORD

FORMATION	CONTENT	FROM	TO	SIZE	PUT IN	PULLED OUT
Surface		0	208'	8 5/8"	208'	0

Describe in detail the manner in which the well was plugged, indicating where the mud fluid was placed and the method or methods used in introducing it into the hole. If cement or other plugs were used, state the character of same and depth placed, from _____ feet to _____ feet for each plug set.

1st. Plug set at 1650' with 20 sacks common cement 50-50 Poz 6% Gel 3% Cal Cl
2nd. Plug set at 1020' with 100 sacks common cement 50-50 Poz 6% Gel 3% Cal Cl
3rd. Plug set at 270' with 40 sacks common cement 50-50 Poz 6% Gel 3% Cal Cl
Solid bridge set at 40' with 10 sacks common cement 50-50 Poz 6% Gel 3% Cal Cl
10 sacks in rathole
Heavy drilling mud between each plug.

(If additional description is necessary, use BACK of this sheet)

Name of Plugging Contractor Allied Cementing
Address Plainville, Ks. 67663



STATE OF Kansas, COUNTY OF Graham, ss.
Jerry M. Helberg (employee of owner) or (owner or operator) of the above-described well, being first duly sworn on oath, says: That I have knowledge of the facts, statements, and matters herein contained and the log of the above-described well as filed and that the same are true and correct. So help me God.

(Signature) Jerry M. Helberg
Box 32 Morland, Ks. 67650
(Address)

SUBSCRIBED AND SWORN to before me this 23 day of December, 1982

My commission expires December 4, 1983

Jessie Redman
Notary Public.

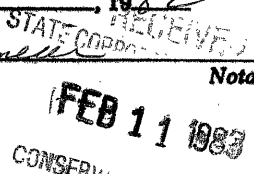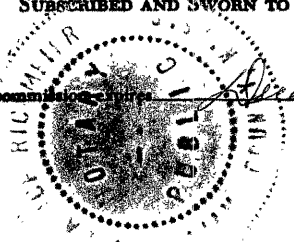

2-11-83