


15-147-20190-00-00

STATE OF KANSAS
STATE CORPORATION COMMISSION
CONSERVATION DIVISION
P. O. BOX 17027
WICHITA, KANSAS 67217

WELL PLUGGING RECORD

Phillips County. Sec. 10 Twp. 5S Rge. 20 (W)
Location as "NE/CNW&SW" or footage from lines C E/2 SE SE
Lease Owner Leland R. Baird
Lease Name States Well No. 1
Office Address Logan, Kansas 67646
Character of Well (completed as Oil, Gas or Dry Hole) Dry Hole
Date well completed April 24 1975
Application for plugging filed (verbally) April 24 1975
Application for plugging approved (verbally) April 24 1975
Plugging commenced April 24 1975
Plugging completed April 24 1975
Reason for abandonment of well or producing formation No commercial quantity of oil encountered.

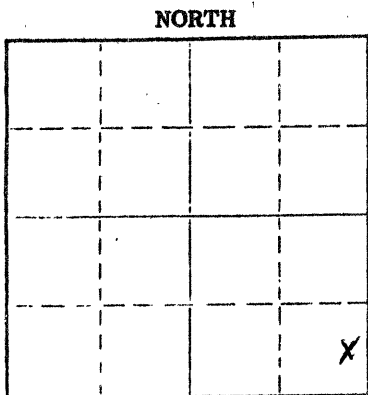

If a producing well is abandoned, date of last production 19
Was permission obtained from the Conservation Division or its agents before plugging was commenced? Yes (verbally)

Name of Conservation Agent who supervised plugging of this well Leo Massey
Producing formation _____ Depth to top _____ Bottom _____ Total Depth of Well 3530' Feet
Show depth and thickness of all water, oil and gas formations.

OIL, GAS OR WATER RECORDS

CASING RECORD

FORMATION	CONTENT	FROM	TO	SIZE	PUT IN	PULLED OUT
				8-5/8"	208'	None

Describe in detail the manner in which the well was plugged, indicating where the mud fluid was placed and the method or methods used in introducing it into the hole. If cement or other plugs were used, state the character of same and depth placed, from _____ feet to _____ feet for each plug set.

1st Plug Set @ 720' with 70 sx. cement
2nd Plug Set @ 215' with 20 sx. cement
3rd Plug Set @ 40' with 10 sx. cement

RECEIVED
STATE CORPORATION COMMISSION

MAY 1 1975

(If additional description is necessary, use BACK of this sheet)
Name of Plugging Contractor Abercrombie Drilling, Inc.
Address 801 Union Center, Wichita, Kansas 67202

CONSERVATION DIVISION
Wichita, Kansas

5-1-75

STATE OF KANSAS COUNTY OF SEDGWICK SS.
Jerry A. Langrehr (employee of owner) or (owner or operator) of the above-described well, being first duly sworn on oath, says: That I have knowledge of the facts, statements, and matters herein contained and the log of the above-described well as filed and that the same are true and correct. So help me God.

(Signature) Jerry A. Langrehr
801 Union Center, Wichita, Ks. 67202
(Address)

SUBSCRIBED AND SWORN TO before me this 30th day of April 1975

April 8, 1978

Nancy E. Haner
Nancy E. Haner Notary Public.

