


15-147-00130-00-00

Give All Information Completely  
Make Required Affidavit  
Mail or Deliver Report to:  
Conservation Division  
State Corporation Commission  
211 No. Broadway  
Wichita, Kansas

WELL PLUGGING RECORD

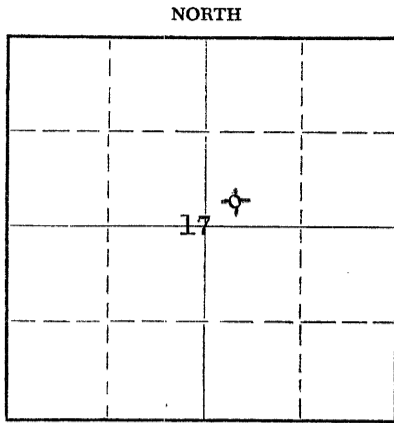

Locate well correctly on above  
Section Plat

Phillips County. Sec. 17 Twp. 5S Rge. (E) 20 (W)  
Location as "NE/CNW/SW" or footage from lines. SW SW NE  
Lease Owner Globe Oil & Refining Co.  
Lease Name Winklebleck Well No. 1  
Office Address 301 S. Market, Wichita 2, Kansas  
Character of Well (completed as Oil, Gas or Dry Hole) Dry Hole  
Date well completed January 20 19 58  
Application for plugging filed (verbal) January 20 19 58  
Application for plugging approved (verbal) January 20 19 58  
Plugging commenced January 20 19 58  
Plugging completed January 20 19 58  
Reason for abandonment of well or producing formation Dry

If a producing well is abandoned, date of last production 19  
Was permission obtained from the Conservation Division or its agents before plugging was commenced? Yes

Name of Conservation Agent who supervised plugging of this well J. Lewis Brock  
Producing formation \_\_\_\_\_ Depth to top \_\_\_\_\_ Bottom \_\_\_\_\_ Total Depth of Well 3664 Feet  
Show depth and thickness of all water, oil and gas formations.


OIL, GAS OR WATER RECORDS

CASING RECORD

FORMATION	CONTENT	FROM	TO	SIZE	PUT IN	PULLED OUT
				8 5/8"	320'	None

Describe in detail the manner in which the well was plugged, indicating where the mud fluid was placed and the method or methods used in introducing it into the hole. If cement or other plugs were used, state the character of same and depth placed, from \_\_\_\_\_ feet to \_\_\_\_\_ feet for each plug set.

Plug #1 at 600' cem. w/ 20 sacks  
Plug #2 at 240' cem. w/ 20 sacks  
Plug #3 at 40' cem. w/ 10 sacks

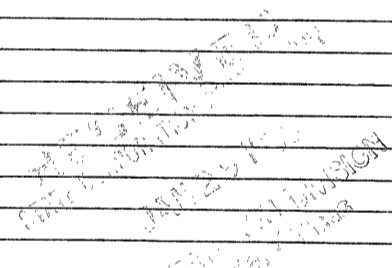

1-29-58

(If additional description is necessary, use BACK of this sheet)  
Name of Plugging Contractor Sterling Drilling Company  
Address Sterling, Kansas

STATE OF Kansas, COUNTY OF Sedgwick, ss.  
Leo Ross (employee of owner) or (owner or operator) of the above-described well, being first duly sworn on oath, says: That I have knowledge of the facts, statements, and matters herein contained and the log of the above-described well as filed and that the same are true and correct. So help me God.

(Signature) Leo Ross  
301 S. Market, Wichita 2, Kansas  
(Address)

SUBSCRIBED AND SWORN TO before me this 28th day of January 19 58

My commission expires July 21, 1958

Frances Leslie  
Notary Public.

PLUG 3  
SEC 17, 5 R 20 W  
PAGE 78 LINE 3

18-147-00130-00-00

GLOBE OIL & REFINING CO.  
No. 1 Winklebleck  
SW SW NE Sec. 17-53-20W  
Phillips County, Kansas

Date Commenced: 1-12-58  
Date Completed: 1-20-58  
Drilling Contractor - Sterling Drilling Company  
Total Depth - 3664'  
I.P. - Dry and Abandoned

Formation	Depth
Sand & shale	100
Shale	600
Shale & shells	950
Sand & shale	1510
Shale & red bed	1690
Anhydrite	1725
Shale & red bed	1875
Shale	2100
Shale & lime	2185
Lime	2320
Lime & shale	2505
Shale & lime	2820
Lime & shale	3100
Shale & lime	3175
Lime	3530
Conglomerate	3580
Shale & conglomerate	3620
Conglomerate	3621
Arbuckle	3664

Casing Record:  
8 5/8" 320' Gen. 200 sacks

Geological Tops - R.B. Meas.

Elevation	2135 D.F.	2138 R.B.
Topeka	3140	-1002
Heebner	3286	-1148
Toronto	3319	-1181
Lansing-K.C.	3334	-1196
Base Kansas City	3526	-1388
Marmaton	3549	-1411
Conglomerate	3580	-1442
Arbuckle	3622	-1484
Rotary T.D.	3664	-1526
Sch. T.D.	3665	-1527

I hereby certify that this is a true and correct log of the above mentioned well.

*Leo Ross*  
Leo Ross

State of Kansas )  
County of Sedgwick ) ss.

PLUGGING  
T.S. 17 T. 5 R. 20  
BOOK PAGE 78 LINE 3

Subscribed and sworn to before me, a notary public, in and for said County and State this 28th day of January, 1958.

*Frances Leslie*  
Notary Public

My Commission expires July 21, 1958.