


15-147-00701-00-00

STATE OF KANSAS
STATE CORPORATION COMMISSION

Give All Information Completely
Make Required Affidavit
Mail or Deliver Report to:
Conservation Division
State Corporation Commission
800 Bitting Building
Wichita, Kansas

WELL PLUGGING RECORD

NORTH

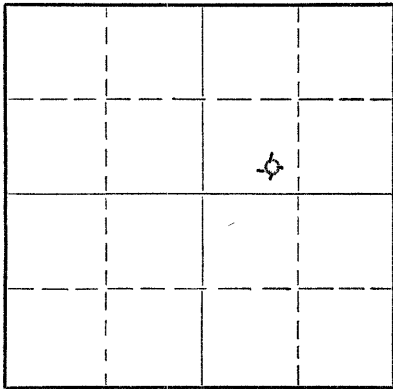

Locate well correctly on above
Section Plat

Phillips County, Sec. 15 Twp. 5 Rge. 20 (X) W (W)
Location as "NE/CNW/SW" or footage from lines SE SW NE
Lease Owner D. G. Hansen
Lease Name Graham Well No. 1
Office Address Logan Kansas
Character of Well (completed as Oil, Gas or Dry Hole) Dry Hole
Date well completed 5-14 1953
Application for plugging filed 5-14 1953
Application for plugging approved 5-14 1953
Plugging commenced 5-14 1953
Plugging completed 5-14 1953
Reason for abandonment of well or producing formation Top low structurally

If a producing well is abandoned, date of last production -- 19
Was permission obtained from the Conservation Division or its agents before plugging was commenced? Yes

Name of Conservation Agent who supervised plugging of this well Eldon Petty, Hays, Kansas
Producing formation _____ Depth to top _____ Bottom _____ Total Depth of Well 3573 Feet
Show depth and thickness of all water, oil and gas formations.

OIL, GAS OR WATER RECORDS

CASING RECORD

| FORMATION | CONTENT | FROM | TO | SIZE | PUT IN | PULLED OUT |
|-----------|---------|------|----|--------|--------|------------|
| | | | | 8 5/8" | 195.35 | |
| | | | | | | |
| | | | | | | |
Describe in detail the manner in which the well was plugged, indicating where the mud fluid was placed and the method or methods used in introducing it into the hole. If cement or other plugs were used, state the character of same and depth placed, from _____ feet to _____ feet for each plug set.

Filled hole with mud to 190'; set plug; 1/2 sack hulls, 15 sacks cement, filled hole with mud to 40'; set plug then filled to top w/10 sacks cement 1/2 sack hulls.

(If additional description is necessary, use BACK of this sheet)

Name of Plugging Contractor C-G DRILLING CO.
Address 544 Petroleum Building, Wichita, Kansas

STATE OF KANSAS, COUNTY OF SEDGWICK, ss. Vicky Jacobs (employee of owner) or (owner or operator) of the above-described well, being first duly sworn on oath, says: That I have knowledge of the facts, statements, and matters herein contained and the log of the above-described well as filed and that the same are true and correct. So help me God.

(Signature) Vicky Jacobs
544 Petroleum Building
(Address)

SUBSCRIBED AND SWORN TO before me this 18th day of May 1953

My commission expires 11/21/55
Marilyn Schmidt
Notary Public.

RECEIVED
2412675-5
MAY 19 1953
CONSERVATION DIVISION
Wichita, Kansas

PLUGGING
FILE SEC 15 T 5 R 204
BOOK PAGE 101 LINE 41

15-147-00701-00-00

CONTRACTOR'S WELL LOG

OPERATOR D. G. HANSEN FARM NAME GRAHAM NO. 1
LOCATION SE SW NE, Sec. 16-5-20W
POOL NAME _____ COUNTY Phillips STATE Kansas
COMMENCEMENT DATE May 6, 1953 COMPLETION DATE May 14, 1953

LOG OF WELL

Elevation: 2130 R. B.
All measurements from the top of rotary bushing.

| FROM | TO | FORMATION | DEVIATION FROM VERTICAL | REMARKS |
|------|------|--------------|-------------------------|---------------|
| 0 | 195 | Sand-Shale | | |
| 195 | 760 | Shale-Shells | | |
| 760 | 785 | Sand | | |
| 785 | 900 | Shale-Shells | | |
| 900 | 1135 | Sand | | |
| 1135 | 1185 | Shale-Shells | | |
| 1185 | 1400 | Sand | | |
| 1400 | 1525 | Shale-Shells | 0° - 1500' | |
| 1525 | 1652 | Red Bed | | |
| 1652 | 1693 | Anhydrite | | |
| 1693 | 1865 | Lime-Shale | | |
| 1865 | 2145 | Lime-Shale | 0° - 2000' | |
| 2145 | 2370 | Shale-Lime | | |
| 2370 | 2565 | Lime-Shale | 0° - 2500' | |
| 2565 | 2745 | Lime-Shale | | |
| 2745 | 2890 | Lime-Shale | | |
| 2890 | 2995 | Lime-Shale | | |
| 2995 | 3060 | Lime-Shale | 0° - 3000' | |
| 3060 | 3128 | Shale-Lime | | |
| 3128 | 3210 | Shale-Lime | | |
| 3210 | 3280 | Lime-Shale | | |
| 3280 | 3335 | Lime-Shale | | |
| 3335 | 3378 | Lime | | |
| 3378 | 3420 | Lime | | |
| 3420 | 3475 | Lime-Shale | | |
| 3475 | 3535 | Lime-Shale | 0° - 3500' | |
| 3535 | 3561 | Shale-Lime | | |
| 3561 | 3565 | Lime | | DST 3559-3565 |
| 3565 | 3573 | Lime | | DST 3551-3573 |

CASING LEFT IN HOLE AFTER COMPLETION

Ran 195.35' (6 jts) 8 5/8" OD 24# casing.

STATE OF KANSAS, COUNTY OF SEDGWICK) ss.

PLUGGING
FILE SEC-16-T-5-R-20W
BOOK PAGE 101 LINE 41

The undersigned certifies that to the best of her knowledge and belief, the above facts are true and correct.

C-G DRILLING CO.

By Vicky Jacobs

Subscribed and sworn to before me this 18th day of May, 1953.

My Commission expires: 11/21/55

RECEIVED
STATE CORPORATION COMMISSION
MAY 19 1953

Marilee Schmidt
Notary Public

CONSERVATION DIVISION
Wichita, Kansas