


STATE OF KANSAS
STATE CORPORATION COMMISSION

Give All Information Completely
Make Requested Affidavit
Mail or Deliver Report to:
Conservation Division
State Corporation Commission
800 Bitting Building
Wichita, Kansas

15-147-00700-00-00
WELL PLUGGING RECORD

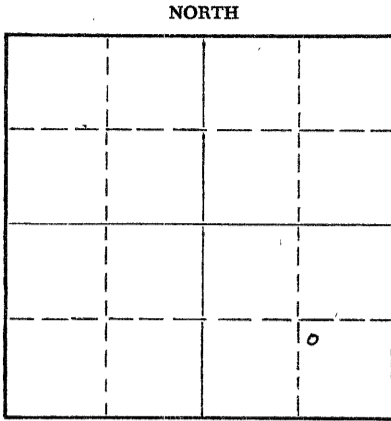

Locate well correctly on above
Section Plat

Phillips County. Sec. 15 Twp. 5 Rge. (E) 20(W)
Location as "NE/CNW/SW" or footage from lines NW SE SE
Lease Owner Cities Service Oil Co.
Lease Name Hansen F Well No. 2
Office Address Bartlesville, Oklahoma
Character of Well (completed as Oil, Gas or Dry Hole) dry hole
Date well completed 10/16/55 19
Application for plugging filed 10/17/55 19
Application for plugging approved 10/19/55 19
Plugging commenced 10/16/55 19
Plugging completed 10/17/55 19
Reason for abandonment of well or producing formation -
If a producing well is abandoned, date of last production - 19
Was permission obtained from the Conservation Division or its agents before plugging was commenced? yes

Name of Conservation Agent who supervised plugging of this well Mr. Eldon Petty
Producing formation Arb. Depth to top _____ Bottom _____ Total Depth of Well 3577 Feet
Show depth and thickness of all water, oil and gas formations.

OIL, GAS OR WATER RECORDS

CASING RECORD

FORMATION	CONTENT	FROM	TO	SIZE	PUT IN	PULLED OUT
				8-5/8"	200'	0'

Describe in detail the manner in which the well was plugged, indicating where the mud fluid was placed and the method or methods used in introducing it into the hole. If cement or other plugs were used, state the character of same and depth placed, from _____ feet to _____ feet for each plug set.

Filled with heavy rotary mud to bottom of surface pipe at 190' set wooden plug, dump 1/2 sack hulls and 15 sacks cement, fill with mud to 40', set wooden plug, dump 1/2 sack hulls and ten sacks cement to surface.

RECEIVED
STATE CORPORATION COMMISSION
OCT 25 1955
CONSERVATION DIVISION
WICHITA, KANSAS

(If additional description is necessary, use BACK of this sheet)
Name of Plugging Contractor Barbour Drlg. Co.
Address Tulsa, Oklahoma 11-23-55

STATE OF KANSAS, COUNTY OF BARTON, ss.
M. M. Hardin (employee of owner) or ~~owner or operator~~ of the above-described well, being first duly sworn on oath, says: That I have knowledge of the facts, statements, and matters herein contained and the log of the above-described well as filed and that the same are true and correct. So help me God.

(Signature) M. M. Hardin
Box 553, Russell, Kansas
(Address)

SUBSCRIBED AND SWORN TO before me this 26th day of October, 1955

My commission expires March 17, 1959 W. J. Smith Notary Public.

PLUGGING
FILE REC 15 T 5 R 200
BOOK PAGE 9 LINE 27

WELL RECORD

Company Cities Service Oil Well No. 2 Farm Hansen "F"
 Location 990' north & 990' west of SE Corner Sec. 15 T. 5 R. 20W
 Elevation 2133 (2131 Gr.) County Phillips State Kansas
 Drlg. Comm. 10-6-55 Contractor Barbour Drilling Company
 Drlg. Comp. 10-16-55 Acid None
 T. D. 3577' Initial Prod. Dry Hole P & A 10-16-55

CASING RECORD:

8 5/8" @ 200' cemented with 250 sacks

FORMATION RECORD:

clay & shells	0-40
sand & shells	90
shale & shells	211
shale	685
sand & shale	1320
shale	1650
shale & shells	1945
anhydrite	1975
shale	2005
lime & shale	2245
shale	2385
shale & lime	2541
lime	2680
shale	2840
shale & lime	2900
lime & shale	3178
lime	3395
lime & shale	3440
lime	3538
lime, shale & sand	3555
lime	3577 TD

Heebner	3228
Dodge	3253
Lansing	3272
Gorham Sand	3534
Arbuckle	3558
Penetration	19'
Total Depth	3577

DST 3537-62, open 1 hr., recovered 130' thin mud; BHP 790#/30 minutes.
 DST 3545-67, open 1 hr., recovered 610' thin slightly oil-cut mud & 10' muddy oil; BHP 930#/30 minutes.
 DST 3566-77, open 1 hr., recovered 90' muddy salt water with trace oil; BHP 760# in 30 minutes.

SYFO:

500'	- 0°
1000'	- 1°
1500'	- 0°
2000'	- 0°
2500'	- 0°

7 7/8" Rotary Hole

PLUGGING
 FILE SEC 15 T. 5 R. 20W
 BOOK PAGE 9 LINE 37

RECEIVED
 STATE CORPORATION COMMISSION
 NOV 23 1955
 CONSERVATION DIVISION
 Wichita, Kansas

11-23-55

