


15-147-00504-00-00

STATE OF KANSAS  
STATE CORPORATION COMMISSION

Form CP-4

Give All Information Completely  
Make Required Affidavit  
Mail or Deliver Report to:  
Conservation Division  
State Corporation Commission  
212 No. Market  
Wichita, Kansas 67202

WELL PLUGGING RECORD

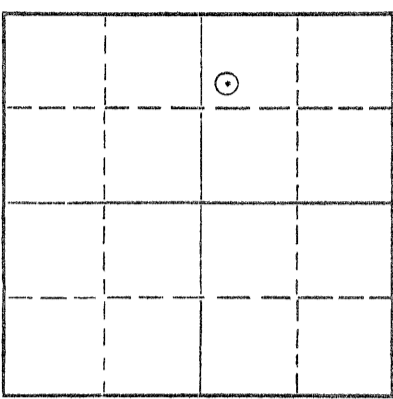

Locate well correctly on above  
Section Plat

Phillips County, Sec. 29 Twp. 5S Rge. (E) 20 (W)

Location as "NE/CNW%SW%" or footage from lines C SW NW NE

Lease Owner Cities Service Oil Company

Lease Name Reese "D" Well No. 3

Office Address Box 553 Russell, Kansas 67665

Character of Well (completed as Oil, Gas or Dry Hole) Oil

Date well completed September 1 1970

Application for plugging filed August 19 1970

Application for plugging approved August 20 1970

Plugging commenced September 14 1970

Plugging completed September 16 1970

Reason for abandonment of well or producing formation No longer economical -

no remedial possibilities

If a producing well is abandoned, date of last production October 9 1968

Was permission obtained from the Conservation Division or its agents before plugging was commenced? Yes

Name of Conservation Agent who supervised plugging of this well Mr. Leo Massey

Producing formation Reagan Depth to top 3622' Bottom - Total Depth of Well 3633 Feet

Show depth and thickness of all water, oil and gas formations.

OIL, GAS OR WATER RECORDS

CASING RECORD

FORMATION	CONTENT	FROM	TO	SIZE	PUT IN	PULLED OUT
				8 5/8"	199'	none
				5 1/2"	3631'	680'

Describe in detail the manner in which the well was plugged, indicating where the mud fluid was placed and the method or methods used in introducing it into the hole. If cement or other plugs were used, state the character of same and depth placed, from \_\_\_\_\_ feet to \_\_\_\_\_ feet for each plug set.

Checked top cement 3324' - shot casing at 1483' worked casing 7" tension

Shot casing 973' - worked pipe - no gain

Shot casing 778' - worked pipe - no gain

Shot casing 686' - worked casing loose

Pulled 24 Jts. 5 1/2" casing - tally 676'

Rigged up Halliburton - Pumped in 4 sacks hulls,

15 sacks gel at 150#, 70 cu. ft. cement at 200#

10 sacks gel at 200#, 250 cu. ft. cement at 250# plus

2 bbls. flush water. Shut casing in at 400# Checked

fill at 23 feet. Filled 8 5/8" casing from 23' to

surface with cement.

Cut casing off and welded on steel cap.

RECEIVED  
STATE CORPORATION COMMISSION  
NOV 19 1970  
CONSERVATION DIVISION  
WICHITA, KANSAS

11-19-70

(If additional description is necessary, use BACK of this sheet)

Name of Plugging Contractor Halliburton Company

Address Hays, Kansas

STATE OF Kansas, COUNTY OF Russell, ss.

E. W. Peterman (employee of owner) or (owner or operator) of the above-described

well, being first duly sworn on oath, says: That I have knowledge of the facts, statements, and matters herein contained and the log of the

above-described well as filed and that the same are true and correct. So help me God.

(Signature) E. W. Peterman

Box 553 Russell, Kansas 67665

(Address)

SWORN TO before me this 18th day of November, 1970

James A. Kyger

Notary Public.

10-5-72

