

CARD MUST BE TYPED

State of Kansas

CARD MUST BE SIGNED

NOTICE OF INTENTION TO DRILL

(see rules on reverse side)

Expected Spud Date September 22, 1987
month day year

API Number 15-147-20,502-00-00 ✓

OPERATOR: License # 5447

SW. SE. NE. Sec. 18... Twp. 5... S, Rg. 20... West
3060... Ft. from South Line of Section
1300... Ft. from East Line of Section

Name Cities Service Oil & Gas Corp.

Address 3545 NW 58th Street

City/State/Zip Oklahoma City, Oklahoma

Contact Person Raymond Hui

Phone (405) 949-4400

(Note: Locate well on Section Plat on reverse side)

Nearest lease or unit boundary line 420 feet

County Phillips

Lease Name Wiltrout Well # 5 SWD

Ground surface elevation 2041 feet MSL

Domestic well within 330 feet: yes no

Municipal well within one mile: yes no

Depth to bottom of fresh water 70

Depth to bottom of usable water 1200

Surface pipe by Alternate: 1 2

Surface pipe planned to be set 300

Conductor pipe required no

Projected Total Depth 3750 feet

Formation Arbuckle

CONTRACTOR: License # 5671

Name Ravin Drilling

City/State Russell, Kansas

Well Drilled For: Well Class: Type Equipment:

Oil Storage Infield Mud Rotary

Gas Inj Pool Ext. Air Rotary

OWWO Expl Wildcat Cable

If OWWO: old well info as follows:

Operator

Well Name

Comp Date Old Total Depth

I certify that well will comply with K.S.A. 55-101, et seq., plus eventually changing hole to KCC specifications:

Date 9/21/87 Signature of Operator or Agent Andrew J. McCalmont

Andrew J. McCalmont Title Engineer

For KCC Use:

Conductor Pipe Required feet; Minimum Surface Pipe Required 200 feet per Alt. X2


This Authorization Expires 3-21-88 Eff. date 9-26-87 Approved By R.H. 9-21-87

Must be filed with the K.C.C. five (5) days prior to commencing well
 This card void if drilling not started within six (6) months of date received by K.C.C.

Important procedures to follow:

- I. Notify District office before setting surface casing.
2. Set surface casing by circulating cement to the top.
3. File completion forms ACO-1 with K.C.C. within 120 days of well spud date, following instructions on ACO-1, side 1, and including copies of wireline logs.
4. Notify District office 48 hours prior to old well workover or re-entry.
5. Prior to filing Intent, prepare a proposed plugging plan in case well is D & A, then obtain approval of plan when calling district office prior to setting surface pipe.
6. Submit plugging report (CP-4) to K.C.C. after plugging is completed.
7. Obtain an approved injection docket number before disposing of salt water.
8. Notify K.C.C. within 10 days when injection commences or terminates.
9. If an alternate 2 completion, cement in the production pipe from below any usable water to surface within 120 days of spud date.

A Regular Section of Land
1 Mile = 5,280 Ft.

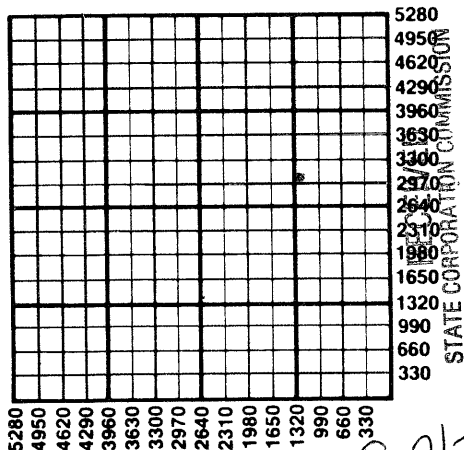

SEP 21 1987

CONSERVATION DIVISION
 Wichita, Kansas 5.

State Corporation Commission of Kansas
 Conservation Division
 200 Colorado Derby Building
 Wichita, Kansas 67202-1212
 (316) 263-3238