

ORIGINAL SIDE ONE

15-147-19114-00-01

STATE CORPORATION COMMISSION OF KANSAS  
OIL & GAS CONSERVATION DIVISION  
RECOMPLETION FORM  
ACO-2 AMENDMENT TO WELL HISTORY

API NO. 15-Not assigned: Well was completed on 9/15/48

County Phillips

CNE SW SE Sec. 29 Twp. 5S Rge. 20 East West

990' Ft. North from Southeast Corner of Section

1650' Ft. West from Southeast Corner of Section  
(NOTE: Locate well in section plat below.)

Lease Name Noel Well # 4

Field Name Ray

Producing Formation Reagan

Elevation: Ground 2204' KB 2206'

Operator: License # 5447

Name: OXY USA, Inc.

Address: P.O. BOX 26100

City/State/Zip: OKLA. CITY, OK 73126-0100

Purchaser: Citgo

Operator Contact Person: Raymond Hui  
Phone: (405) 749-2471

Designate Type of Original Completion  
 New Well  Re-Entry  Workover

Date of Original Completion 9/15/48

Name of Original Operator OXY USA INC.

Original Well Name Noel 4

Date of Recompletion: 8/29/91 9/12/91


Commenced Completed

Re-entry  Workover

Designate Type of Recompletion/Workover:  
 Oil  SWD  Temp. Abd.  
 Gas  Inj  Delayed Comp.  
 Dry  Other (Core, Water Supply, etc.)

Deepening  Re-perforation  
 Plug Back  PBTD  
 Conversion to Injection/Disposal

Is recompleted production:  
 Commingled Docket No. \_\_\_\_\_  
 Dual Completion Docket No. \_\_\_\_\_  
 Other (Disposal or Injection?) Docket No. \_\_\_\_\_

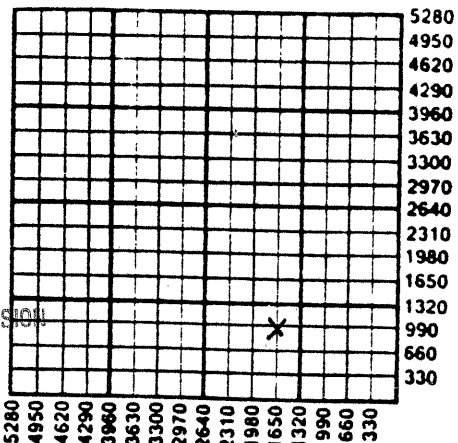

RECEIVED  
STATE CORPORATION COMMISSION  
NOV 4 1991

K.C.C. OFFICE USE ONLY  
F  Letter of Confidentiality Attached  
C  Wireline Log Received  
C  Drillers Timelog Received  
Distribution  
 KCC  SWD/Rep  NGPA  
 KGS  Plug  Other (Specify)

INSTRUCTIONS: This form shall be completed in triplicate and filed with the Kansas Corporation Commission, 200 Colorado Derby Building, Wichita, Kansas 67202, within 120 days of the recompletion of any well. Rules 82-3-107 and 82-3-141 apply. Information on side two of this form will be held confidential for a period of 12 months if requested in writing and submitted with the form. See rule 82-3-107 for confidentiality in excess of 12 months. One copy of any additional wireline logs and driller's time logs (not previously submitted) shall be attached with this form. Submit ACO-4 or ACO-5 prior to or with this form for approval of commingling or dual completions. Submit CP-1 with all plugged wells. Submit CP-111 with all temporarily abandoned wells. NOTE: Conversion of wells to either disposal or injection must receive approval before use; submit form U-1.

All requirements of the statutes, rules and regulations promulgated to regulate the oil and gas industry have been fully complied with and the statements herein are complete and correct to the best of my knowledge.

Signature Vic Tumlinson Title Operations Drilling Manager Date 10-30-91

Subscribed and sworn to before me this 30th day of October 1991

Notary Public Kelly D. Andrews Date Commission Expires 8/19/95

**SIDE TWO**

Operator Name OXY USA, Inc. Lease Name Noel Well # 4  
 Sec. 29 Twp. 5S Rge. 20  East  West  
 County Phillips

**RECOMPLETION FORMATION DESCRIPTION**

Log  Sample

No new log has been run.

	<u>Top</u>	<u>Bottom</u>
Arbuckle/Reagan	3596'	3611'

**ADDITIONAL CEMENTING/SQUEEZE RECORD**

Purpose: <input type="checkbox"/> Perforate <input type="checkbox"/> Protect Casing <input type="checkbox"/> Plug Back TD <input type="checkbox"/> Plug Off Zone <input checked="" type="checkbox"/> Deepen	Depth		Type of Cement	# Sacks Used	Type and Percent Additives
	Top	Bottom			
	3596'	3611'	No additional cementing/squeeze work.		

Shots Per Foot	PERFORATION RECORD	Acid, Fracture, Shot, Cement Squeeze Record
	Specify Footage of Each Interval Perforated	(Amount and Kind of Material Used)
	No new perf.	Not treated.

PBTD 3607' Plug Type Cement plug.

**TUBING RECORD**

Size 2 7/8" Set At 3611' Packer At \_\_\_\_\_ Was Liner Run  Y  N

Date of Resumed Production, Disposal or Injection 9-12-91

Estimated Production Per 24 Hours Oil 5 Bbls. Water \_\_\_\_\_ Bbls. Gas-Oil-Ratio \_\_\_\_\_  
 Gas \_\_\_\_\_ Mcf

Disposition of Gas:

Vented  Sold  Used on Lease (If vented, submit ACO-18.)

