


15-147-20152-00-00

STATE OF KANSAS
STATE CORPORATION COMMISSION

Form CP-4

Give All Information Completely
Make Required Affidavit
Mail or Deliver Report to:
Conservation Division
State Corporation Commission
P. O. Box 17027
Wichita, Kansas 67217
NORTH

WELL PLUGGING RECORD

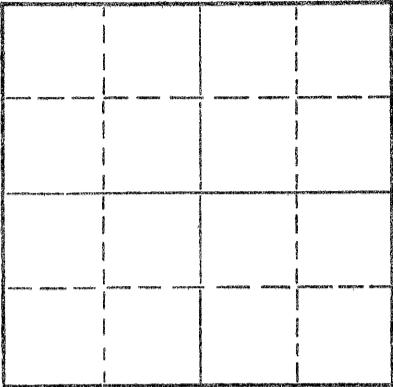

Locate well correctly on above
Section Plat

Phillips County, Sec. 27 Twp. 5S Rge. (E)20 (W)
Location as "NE/CNW&SWX" or footage from lines NW NE NE
Lease Owner Leland R. Baird
Lease Name Steele Trust Well No. 1
Office Address First National Bank - Logan, Kansas
Character of Well (completed as Oil, Gas or Dry Hole) dry
Date well completed 4-20 19 72
Application for plugging filed 4-20 19 72
Application for plugging approved 4-20 19 72
Plugging commenced 12:00 AM 4-20 19 72
Plugging completed 22 3:00 AM 4-20 19 72
Reason for abandonment of well or producing formation dry

If a producing well is abandoned, date of last production none 19
Was permission obtained from the Conservation Division or its agents before plugging was commenced? yes

Name of Conservation Agent who supervised plugging of this well Leo Massey
Producing formation Depth to top Bottom Total Depth of Well 3654 Feet
Show depth and thickness of all water, oil and gas formations.

OIL, GAS OR WATER RECORDS

CASING RECORD

FORMATION	CONTENT	FROM	TO	SIZE	PUT IN	PULLED OUT
Surface Clay		0	220	8 5/8"	220	0

Describe in detail the manner in which the well was plugged, indicating where the mud fluid was placed and the method or methods used in introducing it into the hole. If cement or other plugs were used, state the character of same and depth placed, from feet to feet for each plug set.

Plug hole 70 sx @ 800' 20 sx @ 210'
10 sx @ 40' 2 sx in rat hole by Leo Massey & Halliburton

RECEIVED
STATE CORPORATION COMMISSION
APR 25 1972
CONSERVATION DIVISION
Wichita, Kansas

(If additional description is necessary, use BACK of this sheet)
Name of Plugging Contractor B & B Drilling, Inc. 4-25-72
Address 720 Union Center - Wichita, Kansas 67202

STATE OF Kansas, COUNTY OF Sedgwick, ss.
Bill Lahar (employee of owner) or (owner or operator) of the above-described well, being first duly sworn on oath, says: That I have knowledge of the facts, statements, and matters herein contained and the log of the above-described well as filed and that the same are true and correct. So help me God.

(Signature) Bill Lahar
720 Union Center - Wichita, Kansas
(Address)

SUBSCRIBED AND SWORN TO before me this 24th day of April, 19 72

My commission expires May 31, 1974
Alma A. Neises Notary Public