

15147-00491-00-~~XX~~
01

STATE OF KANSAS
STATE CORPORATION COMMISSION


Form CP-4

Give All Information Completely
Make Required Affidavit
Mail or Deliver Report to:
Conservation Division
State Corporation Commission
212 No. Market
Wichita, Kansas 67202

WELL PLUGGING RECORD

Phillips County, Sec. 28 Twp. 5S Rge. (E) 20 (W)

Location as "NE/CNW/SW" or footage from lines 1650' FSL & 1650' FWL.
Lease Owner Cities Service Oil Company
Lease Name Vehige "A" Well No. 5
Office Address Box 553 Russell, Kansas
Character of Well (completed as Oil, Gas or Dry Hole) Oil
Date well completed 8-2- 19 43
Application for plugging filed 8-23 19 71
Application for plugging approved 8-26 19 71
Plugging commenced 9-14 19 71
Plugging completed 9-22- 19 71
Reason for abandonment of well or producing formation Non Productive

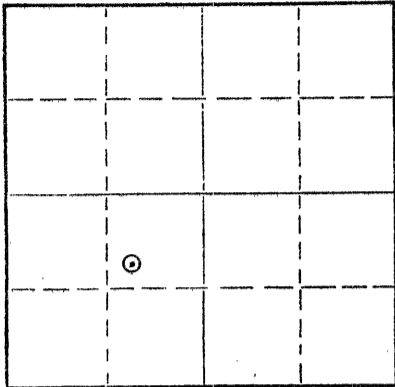

Locate well correctly on above
Section Plat

If a producing well is abandoned, date of last production 7-9 19 69
Was permission obtained from the Conservation Division or its agents before plugging was commenced? Yes

Name of Conservation Agent who supervised plugging of this well Mr. L. Massey
Producing formation Reagan Depth to top 3611' Bottom 3614' Total Depth of Well 3665 Feet
Show depth and thickness of all water, oil and gas formations.

OIL, GAS OR WATER RECORDS

CASING RECORD

FORMATION	CONTENT	FROM	TO	SIZE	PUT IN	PULLED OUT
				8 5/8"	160	None
				5 1/2"	3706'	799'

Describe in detail the manner in which the well was plugged, indicating where the mud fluid was placed and the method or methods used in introducing it into the hole. If cement or other plugs were used, state the character of same and depth placed, from _____ feet to _____ feet for each plug set.

Filled W/sand 3560' to 3440', 3 sacks cement 3440' to 3405'. Pushed plug to 3300', sand to 3295', cement 3295-3281, shot 5 1/2 casing off at 810'. Pulled 799' of 5 1/2" casing. Filled hole W/mud 3281 to 1660', 1 sack hulls and 15 sacks Gel 1660' to 900', 70 sacks cement 900' to 610', 10 sacks gel 610' to 210'; 1 sack hulls and 50 sacks cement 210' to surface. Press. 300 psi
Plugged completed 9-22-71

RECEIVED
STATE CORPORATION COMMISSION
OCT 1 1971
CONSERVATION DIVISION
Wichita, Kansas

10-1-71


(If additional description is necessary, use BACK of this sheet)
Name of Plugging Contractor Knight Casing Pulling Co., Inc.
Address P. O. Box 405, Chase, Kansas 67524

STATE OF Kansas, COUNTY OF Russell, ss.
E. W. Peterman (employee of owner) or (owner or operator) of the above-described well, being first duly sworn on oath, says: That I have knowledge of the facts, statements, and matters herein contained and the log of the above-described well as filed and that the same are true and correct. So help me God.

(Signature) *E. W. Peterman*

Box 553 Russell, Kansas
(Address)

Subscribed and sworn to before me this 30th day of September, 1971

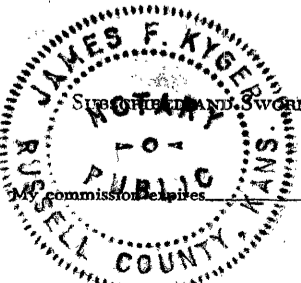

10-5-72

Notary Public.