

Give All Information Completely
Make Required Affidavit
Mail or Deliver Report to:
Conservation Division
State Corporation Commission
800 Bitting Building
Wichita, Kansas

OR

Strike out upper line when reporting plugging off formations.

NORTH

**Locate well correctly on above
Section Plat**

Name of Conservation Agent who supervised plugging of this well..... **C. T. Alexander**
Producing formation..... **None**..... Depth to top..... Bottom..... Total Depth of Well..... **3591** Feet
Show depth and thickness of all water, oil and gas formations.

OIL, GAS OR WATER RECORDS

CASING RECORD

[illegible]

Describe in detail the manner in which the well was plugged, indicating where the mud fluid was placed and the method or methods used in introducing it into the hole. If cement or other plugs were used, state the character of same and depth placed, from.....feet to feet for each plug set.

The hole was filled with mud from 3591' to 160' (14# mud circulated every 500'). A wood plug, rock, and burlap bridge was placed at 160'. 12 sacks cement placed in hole through drill pipe from 160' to 136'. Mud from 136' to 23'. Wood plug at 23'. 12 sacks cement from 23' to top of surface pipe.

(If additional description is necessary, use BACK of this sheet)

Correspondence regarding this well should be addressed to..... R. C. Hauber, Cities Service Oil Company,
Address..... Great Bend, Kansas

STATE OF Kansas, COUNTY OF Russell, ss.

J. A. Cleverley

(employee of owner) ~~or owner or operator~~ of the above-described well,

being first duly sworn on oath, says: That I have knowledge of the facts, statements, and matters herein contained and the log of the above-described well as filed and that the same are true and correct. So help me God.

(Signature)


Cities Service Oil Company, Russell, Kans.

(Address)

SUBSCRIBED AND SWORN to before me this 27th day of February, 1972

My commission expires.

Notary Public.

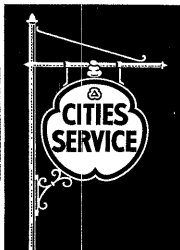

15-147-19/20-00-00

CITIES SERVICE OIL COMPANY

PRODUCERS-REFINERS-MARKETERS OF PETROLEUM PRODUCTS

BARTLESVILLE
OKLAHOMA

Great Bend, Kansas
March 3, 1942

State Corporation Commission
Conservation Division
800 Bitting Building
Wichita, Kansas

Gentlemen:

Attached herewith is Well Plugging Record of the work done in connection with plugging and abandoning our Johnson "B" well No. 6, Section 31-5-20W, Phillips County, Kansas, drilled as a dry hole.



To complete all records, we are also attaching written Well Plugging Application, together with log of the well.

Yours very truly,

CITIES SERVICE OIL COMPANY

R. C. Hauber

EH:
Attach.

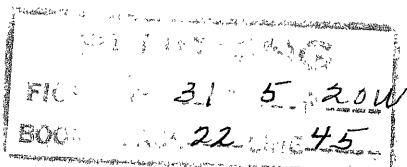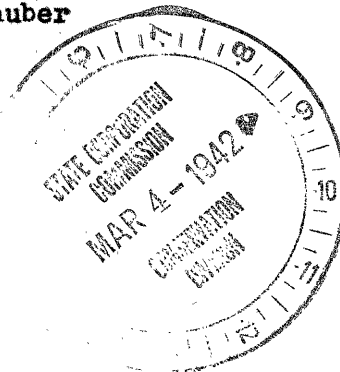

3-4-42