

15-147-00511-00-00

STATE OF KANSAS
STATE CORPORATION COMMISSION

Form CP-4

Give All Information Completely
Make Required Affidavit
Mail or Deliver Report to:
Conservation Division
State Corporation Commission
212 No. Market
Wichita, Kansas 67202

WELL PLUGGING RECORD

Phillips County. Sec. 30 Twp. 5S Rge. (E) 20 (W)

Location as "NE/CNW&SW" or footage from lines. 1650' FNL & 330' FEL

Lease Owner Cities Service Oil Company

Lease Name Bailey "A" Well No. 3

Office Address Box 553 Russell, Kansas 67665

Character of Well (completed as Oil, Gas or Dry Hole) Oil

Date well completed 12-16 19 49

Application for plugging filed 10-1 19 71

Application for plugging approved 10-6 19 71


Plugging commenced 11-30 19 71

Plugging completed 12-3 19 71

Reason for abandonment of well or producing formation Depleted

If a producing well is abandoned, date of last production 8-11 19 70

Was permission obtained from the Conservation Division or its agents before plugging was commenced? Yes

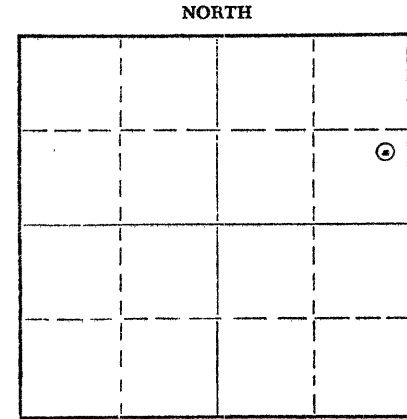

Locate well correctly on above
Section Plat

Name of Conservation Agent who supervised plugging of this well Mr. Leo Massey

Producing formation Reagan Depth to top 3642' Bottom 23' Pen Total Depth of Well 3665 Feet

Show depth and thickness of all water, oil and gas formations.

OIL, GAS OR WATER RECORDS

CASING RECORD

FORMATION	CONTENT	FROM	TO	SIZE	PUT IN	PULLED OUT
				8 5/8"	207'	None
				5 1/2"	3665'	607'

Describe in detail the manner in which the well was plugged, indicating where the mud fluid was placed and the method or methods used in introducing it into the hole. If cement or other plugs were used, state the character of same and depth placed, from _____ feet to _____ feet for each plug set.

Checked hole, ran sand to 3025' and dumped 5 sx. cement @ 3025'.
Shot pipe and pulled 19 Joints. Squeezed well with 20 sx. gel, 15 Sx.
hulls and 100 Sx. Pozmix cement.

RECEIVED
STATE CORPORATION COMMISSION
DEC 20 1971
CONSERVATION DIVISION
Wichita, Kansas

12-20-71

(If additional description is necessary, use BACK of this sheet)

Name of Plugging Contractor Knight Casing Pulling Co., Inc.

Address P. O. Box 405 Chase, Kansas 67524


STATE OF Kansas, COUNTY OF Russell, ss.
E. W. Peterman (employee of owner) or (owner or operator) of the above-described well, being first duly sworn on oath, says: That I have knowledge of the facts, statements, and matters herein contained and the log of the above-described well as filed and that the same are true and correct. So help me God.

(Signature) *E. W. Peterman*

Box 553 Russell, Kansas 67665

(Address)

Subscribed and Sworn to before me this 17th day of December, 19 71

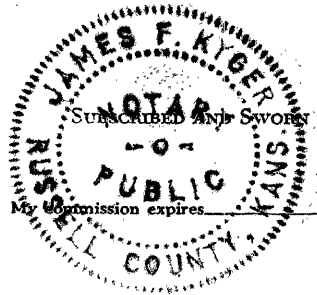

10-5-72

Notary Public.