

15-147-00512-00-00

STATE OF KANSAS
STATE CORPORATION COMMISSION


Form CP-4

Give All Information Completely
Make Required Affidavit
Mail or Deliver Report to:
Conservation Division
State Corporation Commission
212 No. Market
Wichita, Kansas 67202

WELL PLUGGING RECORD

Phillips County, Sec. 30 Twp. 5S Rge. (E) 20 (W)

Location as "NE/CNW4SW4" or footage from lines 2310' FNL & 1650' FWL
Lease Owner Cities Service Oil Company
Lease Name Bailey "A" Well No. 4
Office Address Box 553 Russell, Kansas 67665
Character of Well (completed as Oil, Gas or Dry Hole) Oil
Date well completed 11-13 1951
Application for plugging filed 10-1 1971
Application for plugging approved 10-6 1971
Plugging commenced 11-26 1971
Plugging completed 12-3- 1971
Reason for abandonment of well or producing formation Depleted

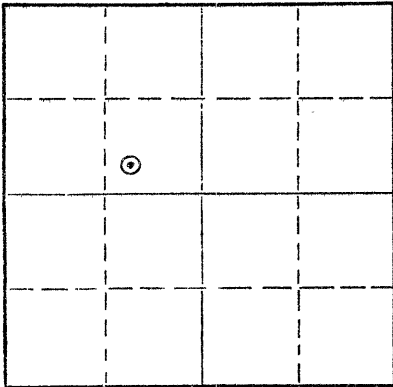

Locate well correctly on above
Section Plat

If a producing well is abandoned, date of last production 2-24 19 68
Was permission obtained from the Conservation Division or its agents before plugging was com-
menced? Yes

Name of Conservation Agent who supervised plugging of this well Mr. Leo Massey
Producing formation Reagan Depth to top 3651' Bottom 2' Pen. Total Depth of Well 3653 Feet
Show depth and thickness of all water, oil and gas formations.

OIL, GAS OR WATER RECORDS

CASING RECORD

FORMATION	CONTENT	FROM	TO	SIZE	PUT IN	PULLED OUT
				8 5/8"	200'	None
				5 1/2"	3645'	514'

Describe in detail the manner in which the well was plugged, indicating where the mud fluid was placed and the method or methods used in introducing it into the hole. If cement or other plugs were used, state the character of same and depth placed, from _____ feet to _____ feet for each plug set.

Checked hole, ran sand to 3640' and dumped 5 sx. cement
loaded hole, shot pipe and pulled 12 joints.
Squeezed well with 20 sx. gel, 15 sx. hulls, and 100 sx.
Pozmix cement

RECEIVED
STATE CORPORATION COMMISSION
DEC 20 1971
CONSERVATION DIVISION
Wichita, Kansas

12-20-71

(If additional description is necessary, use BACK of this sheet)
Name of Plugging Contractor Knight Casing Pulling Co., Inc.
Address P. O. Box 405 Chase, Kansas 67524

STATE OF Kansas, COUNTY OF Russell, ss.
E. W. Pterman (employee of owner) or (owner or operator) of the above-described well, being first duly sworn on oath, says: That I have knowledge of the facts, statements, and matters herein contained and the log of the above-described well as filed and that the same are true and correct. So help me God.

(Signature) *E. W. Pterman*

Box 553 Russell, Kansas 67665

(Address)

71

19

Subscribed and sworn to before me this 17th day of December, 1971

10-5-72

James A. Kyger

Notary Public.

