

15-137-00290-00-00

STATE OF KANSAS
STATE CORPORATION COMMISSION

Form CP-4

Give All Information Completely
Make Required Affidavit
Mail or Deliver Report to:
Conservation Division
State Corporation Commission
211 No. Broadway
Wichita, Kansas

WELL PLUGGING RECORD

Norton County, Sec. 18 Twp. 5 Rge. 21 (E) W (W)

Location as "NE/CNW/SW" or footage from lines SW NW NW

Lease Owner Dane G. Hansen Trust

Lease Name Noone Well No. 2

Office Address Logan, Kansas

Character of Well (completed as Oil, Gas or Dry Hole) Dry Hole OIL

Date well completed February 7, 19 64

Application for plugging filed April 23, 19 70

Application for plugging approved April 24, 19 70

Plugging commenced August 13, 19 70


Plugging completed August 13, 19 70

Reason for abandonment of well or producing formation

Excessive produced water

If a producing well is abandoned, date of last production 19

Was permission obtained from the Conservation Division or its agents before plugging was commenced? Yes

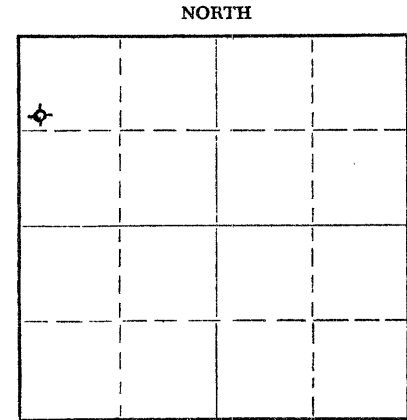

Locate well correctly on above Section Plat

Name of Conservation Agent who supervised plugging of this well Bill Nichols

Producing formation Reagan Depth to top 3537 Bottom 3539 Total Depth of Well 3539 Feet

Show depth and thickness of all water, oil and gas formations.

OIL, GAS OR WATER RECORDS

CASING RECORD

FORMATION	CONTENT	FROM	TO	SIZE	PUT IN	PULLED OUT
				8 5/8"	200'	None
				4 1/2"	3537 1/2	2511.33'

Describe in detail the manner in which the well was plugged, indicating where the mud fluid was placed and the method or methods used in introducing it into the hole. If cement or other plugs were used, state the character of same and depth placed, from feet to feet for each plug set.

Squeezed off with 5 sacks hulls and 12 Gel. Staged with 100 sacks cement from 950' to 625'; 19 sacks Gel from 625' to 225'; 25 sacks cement 225' to 150', 3 sacks Gel 150' to 30'; 10 sacks cement 30' to cellar. Max. pressure 400#. Shut in pressure 200#.

RECEIVED
STATE CORPORATION COMMISSION
SEP 30 1970
CONSERVATION DIVISION
Wichita, Kansas

9-30-70

(If additional description is necessary, use BACK of this sheet)

Name of Plugging Contractor Halliburton

Address Hays, Kansas


STATE OF Kansas, COUNTY OF Phillips, ss.

Dane G. Bales, Manager for (employee of owner) (owner or operator) of the above-described well, being first duly sworn on oath, says: That I have knowledge of the facts, statements, and matters herein contained and the log of the above-described well as filed and that the same are true and correct. So help me God.

(Signature) Dane G. Bales

Logan, Kansas (Address)

SUBSCRIBED AND SWORN to before me this 25th day of September, 19 70

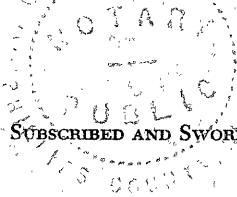

A. G. E. Cummings Notary Public.

My commission expires Feb 22 1973

