


Give All Information Completely  
Make Required Affidavit  
Mail or Deliver Report to:  
Conservation Division  
State Corporation Commission  
211 No. Broadway  
Wichita, Kansas

WELL PLUGGING RECORD

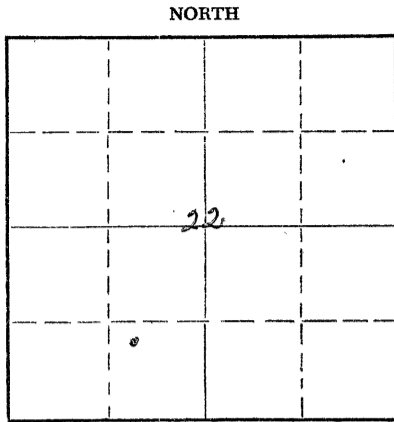

Locate well correctly on above Section Plat

Norton County, Sec. 22 Twp. 5S Rge. (E) 21 (W)  
Location as "NE/CNW/SW" or footage from lines NW-SE-NW SW  
Lease Owner Varn Petroleum Company  
Lease Name Kemper Well No. 2  
Office Address 502 Central Bldg., Wichita, Kansas  
Character of Well (completed as Oil, Gas or Dry Hole) oil  
Date well completed 1-26-59 19  
Application for plugging filed 6-25-65 19  
Application for plugging approved 6-28-65 19  
Plugging commenced 6-27-65 19  
Plugging completed 6-29-65 19  
Reason for abandonment of well or producing formation 100% water

If a producing well is abandoned, date of last production May XXXXX 1 19 65  
Was permission obtained from the Conservation Division or its agents before plugging was commenced? yes

Name of Conservation Agent who supervised plugging of this well W. L. Nichols  
Producing formation Arbuckle Depth to top 3664 Bottom -- Total Depth of Well 3669 Feet  
Show depth and thickness of all water, oil and gas formations.

OIL, GAS OR WATER RECORDS

CASING RECORD

FORMATION	CONTENT	FROM	TO	SIZE	PUT IN	PULLED OUT
Topeka	Tested Salt Wtr.	3343	3347	8-5/8	209	00
Lansing, K.C.	Oil shows	3428	3502	5 1/2	3665 1/2	2337
Arbuckle	oil	3664	3669			

Describe in detail the manner in which the well was plugged, indicating where the mud fluid was placed and the method or methods used in introducing it into the hole. If cement or other plugs were used, state the character of same and depth placed, from \_\_\_\_\_ feet to \_\_\_\_\_ feet for each plug set.

Shot casing at 2325'. Pulled casing up to 600' from top. Pumped 13 sacks gel mud and 20 sacks cement thru 5 1/2" casing. Pulled casing up to 200' from top. Pumped 20 sacks cement thru 5 1/2" casing. Finished pulling casing. Removed tools from over hole. Made rock bridge from 40' to 30'. Dumped 10 sacks cement from 30' to top of base.

RECEIVED  
STATE CORPORATION COMMISSION  
JUL 12 1965  
CONSERVATION DIVISION  
Wichita, Kansas

(If additional description is necessary, use BACK of this sheet)  
Name of Plugging Contractor Santa-Fe Pipe & Supply, Inc. 7-12-65  
Address P. O. Box 562, Great Bend, Kansas

STATE OF Kansas, COUNTY OF Sedgwick, ss.  
Otis E. Anderson (employee of owner) or (owner or operator) of the above-described well, being first duly sworn on oath, says: That I have knowledge of the facts, statements, and matters herein contained and the log of the above-described well as filed and that the same are true and correct. So help me God

(Signature) Otis E. Anderson

Varn Petroleum Co., 502 Central Bldg., Wichita, Kansas  
(Address)

SUBSCRIBED AND SWORN TO before me this 9th day of July, 19 65

Jean White  
Notary Public.

My commission expires 6-25-68



15-137-00621-00-00

VARN PETROLEUM COMPANY  
Kemper #2  
Well Log

NW-SE-SW Sec. 22-5S-21E  
Norton County, Kansas

Surface, sand & clay	0- 50
Shale	50- 310
Sand	310- 352
Shale	352- 360
Sand	360- 420
Shale w/sand strks.	420- 644
Sand & shale	644-1250
Shale	1250-1823
Lime	1823-1858
Shale	1858-2153
Shale & lime	2153-2388
Lime & shale	2388-3030
Lime	3030-3134
Shale & lime	3134-3234
Lime w/shale strks.	3234-3380
Shale	3380-3408
Lime	3408-3446
Shale	3446-3462
Lime w/shale strks.	3462-3530
Lime & shale	3530-3654
Sandy dolomite	3654-3669
Hard dolomite	3669-3676. TD

RECEIVED  
STATE CORPORATION COMMISSION

JUL 1 1965

CONSERVATION DIVISION  
Wichita, Kansas

7-1-65