

Give All Information Completely
Make Required Affidavit
Mail or Deliver Report to:
Conservation Division
State Corporation Commission
211 No. Broadway
Wichita, Kansas

WELL PLUGGING RECORD

Norton County, Sec. 22 Twp. 5 Rge. (E) 21 (W)

Location as "NE/CNW/SW" or footage from lines SE/4 SW/4 SE/4

Lease Owner Dane G. Hansen Trust

Lease Name Noel Well No. 1

Office Address Box 187, Logan, Kansas 67646

Character of Well (completed as Oil, Gas or Dry Hole) Oil

Date well completed November 14 19 57

Application for plugging filed December 30 19 75

Application for plugging approved December 31 19 75


Plugging commenced February 3 19 76

Plugging completed February 3 19 76

Reason for abandonment of well or producing formation Oil depleted

If a producing well is abandoned, date of last production 19

Was permission obtained from the Conservation Division or its agents before plugging was commenced? Yes

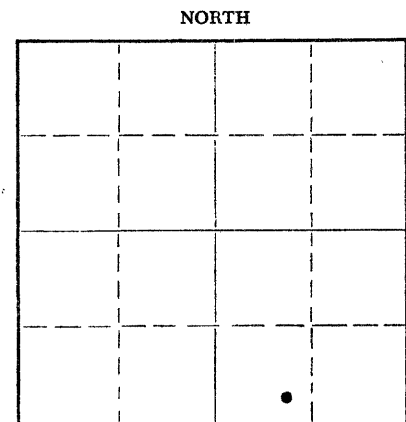

Locate well correctly on above Section Plat

Name of Conservation Agent who supervised plugging of this well Gilbert Balthazor

Producing formation Arbuckle Depth to top 3579 Bottom 3585 Total Depth of Well 3585 Feet

Show depth and thickness of all water, oil and gas formations.

OIL, GAS OR WATER RECORDS

CASING RECORD

FORMATION	CONTENT	FROM	TO	SIZE	PUT IN	PULLED OUT
				8 5/8"	179	None
				5 1/2"	3605	None

Describe in detail the manner in which the well was plugged, indicating where the mud fluid was placed and the method or methods used in introducing it into the hole. If cement or other plugs were used, state the character of same and depth placed, from _____ feet to _____ feet for each plug set.

Pumped 30 bbl. water down casing.
Pumped 2 sacks hulls mixed with water.
Released plug.
Mixed and pumped 100 sacks cement.
No pressure.

RECEIVED
STATE CORPORATION COMMISSION

MAR 19 1976


CONSERVATION DIVISION
Wichita, Kansas

(If additional description is necessary, use BACK of this sheet)
Name of Plugging Contractor Allied Cementing Company 3-19-76
Address Box 31, Russell, Kansas

STATE OF KANSAS, COUNTY OF PHILLIPS, ss.
Dane G. Bales, Manager (employee of owner) or (owner or operator) of the above-described well, being first duly sworn on oath, says: That I have knowledge of the facts, statements, and matters herein contained and the log of the above-described well as filed and that the same are true and correct. So help me God.

(Signature) Dane G. Bales
Logan, Kansas 67646
(Address)

SUBSCRIBED AND SWORN TO before me this 17 day of March, 19 76

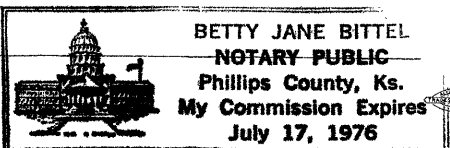

Betty Jane Bittel
Notary Public.

My commission expires