


15-137-00274-00-00

STATE OF KANSAS
STATE CORPORATION COMMISSION

Give All Information Completely
Make Required Affidavit
Mail or Deliver Report to:
Conservation Division
State Corporation Commission
111 No. Broadway
Wichita, Kansas

WELL PLUGGING RECORD

NORTH

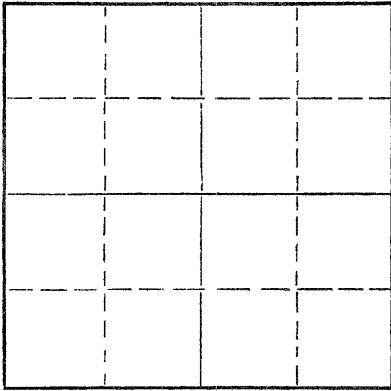

Locate well correctly on above
Section Plat

Norton County. Sec. 21 Twp. 58 Rge. (E) 21W(W)
Location as "NE/CNW4SW4" or footage from lines C NW SE
Lease Owner D & D Drilling Company, Inc. & Lario Oil and Gas Company
Lease Name Williams Well No. B #1
Office Address 308 Schweiter Building
Character of Well (completed as Oil, Gas or Dry Hole) Dry Hole
Date well completed 11-23-62 19__
Application for plugging filed 11-28-62 19__
Application for plugging approved 11-23-62 19__
Plugging commenced 11-23-62 19__
Plugging completed 11-23-62 19__
Reason for abandonment of well or producing formation Dry Hole

If a producing well is abandoned, date of last production _____ 19__
Was permission obtained from the Conservation Division or its agents before plugging was commenced? Yes

Name of Conservation Agent who supervised plugging of this well Eldon Petty, Hays, Kansas
Producing formation _____ Depth to top _____ Bottom _____ Total Depth of Well 3687 Feet
Show depth and thickness of all water, oil and gas formations.

OIL, GAS OR WATER RECORDS

CASING RECORD

FORMATION	CONTENT	FROM	TO	SIZE	PUT IN	PULLED OUT
Surface hole		0	220'	8 5/8"	11-16-62	

Describe in detail the manner in which the well was plugged, indicating where the mud fluid was placed and the method or methods used in introducing it into the hole. If cement or other plugs were used, state the character of same and depth placed, from _____ feet to _____ feet for each plug set.

Filled hole with heavy mud to 500', set plug #1 with 20 sacks of cement, set plug #2 at 200' inside surface pipe with 20 sacks, set plug #3 at 40' with 10 sacks.

RECEIVED
STATE CORPORATION COMMISSION

NOV 29 1962

CONSERVATION DIVISION
Wichita, Kansas

11-29-62

(If additional description is necessary, use BACK of this sheet)

Name of Plugging Contractor D & D Drilling Company, Inc.
Address 308 Schweiter Building, Wichita, Kansas

STATE OF Kansas, COUNTY OF Sedgwick, ss.

James R. Daniels (employee of owner) or (owner or operator) of the above-described well, being first duly sworn on oath, says: That I have knowledge of the facts, statements, and matters herein contained and the log of the above-described well as filed and that the same are true and correct. So help me God.

(Signature)

James R. Daniels
308 Schweiter Building, Wichita, Kansas

SUBSCRIBED AND SWORN TO before me this 28th day of November, 19 62

My commission expires 11-18-66

Colleen Chapple
Colleen Chapple Notary Public.

