


15-137-00164-00-00

STATE OF KANSAS
STATE CORPORATION COMMISSION

Give All Information Completely
Make Required Affidavit
Mail or Deliver Report to:
Conservation Division
State Corporation Commission
211 No. Broadway
Wichita, Kansas

WELL PLUGGING RECORD

NORTH

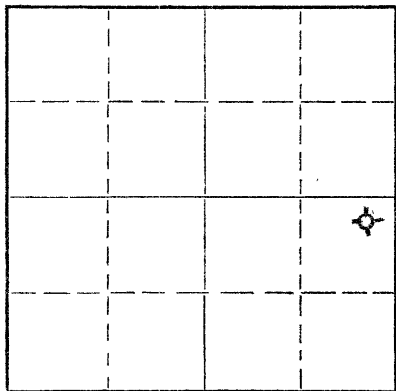

Locate well correctly on above
Section Plat

Norton County. Sec. 20 Twp. 5S Rge. 21 (E) (W) W
Location as "NE/CNW/SW" or footage from lines NE NE SE
Lease Owner C-G Drilling Co. & D. L. Somers, et al
Lease Name Damewood Well No. 1
Office Address 107 Rule Building, Wichita, Kansas
Character of Well (completed as Oil, Gas or Dry Hole) Dry Hole
Date well completed June 27 1960
Application for plugging filed June 27 1960
Application for plugging approved June 27 1960
Plugging commenced June 27 1960
Plugging completed June 27 1960
Reason for abandonment of well or producing formation Too low structurally

If a producing well is abandoned, date of last production 19
Was permission obtained from the Conservation Division or its agents before plugging was commenced? Yes

Name of Conservation Agent who supervised plugging of this well Eldon Petty, Hays, Kansas
Producing formation Depth to top Bottom Total Depth of Well 3767 Feet
Show depth and thickness of all water, oil and gas formations.

OIL, GAS OR WATER RECORDS

CASING RECORD

FORMATION	CONTENT	FROM	TO	SIZE	PUT IN	PULLED OUT
				8-5/8"	200.08'	None

Describe in detail the manner in which the well was plugged, indicating where the mud fluid was placed and the method or methods used in introducing it into the hole. If cement or other plugs were used, state the character of same and depth placed, from feet to feet for each plug set.

Filled hole with heavy mud to 400'. Set plug. Put in 20 sacks cement. Filled to 190'. Set plug. Put in 1/2 sack hulls and 20 sacks cement. Filled with heavy mud up to 40'. Set plug. Filled to top with 1/2 sack hulls and 10 sacks cement.

RECEIVED
STATE CORPORATION COMMISSION

JUN 30 1960

CONSERVATION DIVISION
Wichita, Kansas

6-30-60

(If additional description is necessary, use BACK of this sheet)
Name of Plugging Contractor C-G Drilling Co.
Address 107 Rule Building, Wichita, Kansas

STATE OF KANSAS, COUNTY OF SEDGWICK, ss.
G. F. Galloway (employee of owner) or (owner or operator) of the above-described well, being first duly sworn on oath, says: That I have knowledge of the facts, statements, and matters herein contained and the log of the above-described well as filed and that the same are true and correct. So help me God.

(Signature) G. F. Galloway 107 Rule Building
(Address)

SUBSCRIBED AND SWORN TO before me this 29th day of June, 1960

My commission expires May 20, 1963

Vicky Jacobs Notary Public.