

STATE OF KANSAS
STATE CORPORATION COMMISSION


WELL PLUGGING RECORD

Give All Information Completely
Make Required Affidavit
Mail or Deliver Report to:
Conservation Division
State Corporation Commission
800 Bittling Building
Wichita, Kansas

OR
FORMATION PLUGGING RECORD

Strike out upper line
when reporting plug-
ging off formations.

NORTH

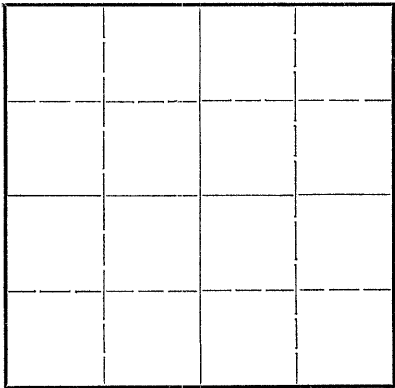

Locate well correctly on above
Section Plat

Norton County. Sec. 16 Twp. 5S Rge. 21 (E) 21 (W)
Location as "NE $\frac{1}{4}$ NW $\frac{1}{4}$ SW $\frac{1}{4}$ " or footage from lines. 330' S.L. & 330' W.L.
Lease Owner Helmerich & Payne, Inc.
Lease Name Kitzkee Well No. 1
Office Address 415 Philtower, Tulsa 3, Oklahoma.
Character of Well (completed as Oil, Gas or Dry Hole) Dry
Date well completed March 5, 19 46
Application for plugging filed March 13, 19 46
Application for plugging approved 19
Plugging commenced March 6, 19 46
Plugging completed March 6, 19 46
Reason for abandonment of well or producing formation Dry

If a producing well is abandoned, date of last production 19
Was permission obtained from the Conservation Division or its agents before plugging was com-
menced? Yes

Name of Conservation Agent who supervised plugging of this well Mr. Kerr
Producing formation Depth to top Bottom Total Depth of Well 3,713 Feet
Show depth and thickness of all water, oil and gas formations.


OIL, GAS OR WATER RECORDS

CASING RECORD

Formation	Content	From	To	Size	Put In	Pulled Out
Lansing-Kansas City	Dry	3,394	3,399	10 3/4"	160	None
Pre-Cambrian	Dry	3,698	3,705			

Describe in detail the manner in which the well was plugged, indicating where the mud fluid was placed and the method or methods used in introducing it into the hole. If cement or other plugs were used, state the character of same and depth placed, from feet to feet for each plug set.

Hole mudded to 165', bridged with rock and 15 sacks of cement from 165' to 140' Mudded hole from 140' to 15' and cemented with 10 sacks of cement to surface.

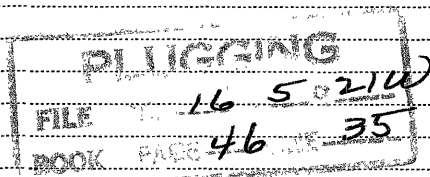

STATE CORPORATION
COMMISSION

MAR 14 1946

3-14-46

(If additional description is necessary, use BACK of this sheet)

Correspondence regarding this well should be addressed to Helmerich & Payne, Inc.
Address 415 Philtower, Tulsa 3, Oklahoma.

STATE OF Oklahoma, COUNTY OF Tulsa, ss.
Harry Saye - - Prod. Supt. (employee of owner) or (owner or operator) of the above-described well,
being first duly sworn on oath, says: That I have knowledge of the facts, statements, and matters herein contained and the log of the above-
described well as filed and that the same are true and correct. So help me God.

(Signature) Harry Saye
415 Philtower, Tulsa 3, Oklahoma.
(Address)

SUBSCRIBED AND SWORN TO before me this 13th day of March, 1946.

My commission expires July 22, 1947.

Sue Griffin
Notary Public.