


15-137-00154-00-00

Give All Information Completely
Make Required Affidavit
Mail or Deliver Report to:
Conservation Division
State Corporation Commission
211 No. Broadway
Wichita, Kansas

WELL PLUGGING RECORD

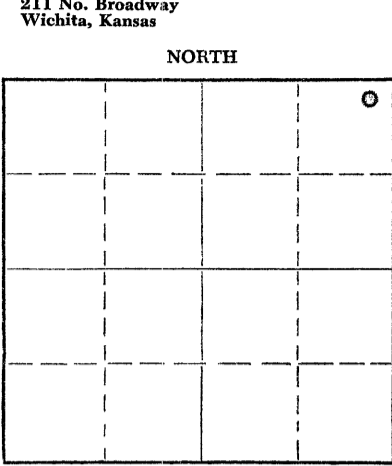

Locate well correctly on above Section Plat

Norton County. Sec. 14 Twp. 5 Rge. 21W (E) (W)
Location as "NE/CNW/SW" or footage from lines NE NE NE
Lease Owner Nadel & Gussman
Lease Name Kemper Well No. 1
Office Address 623 Union Center Bldg. Wichita, Kansas
Character of Well (completed as Oil, Gas or Dry Hole) D & A
Date well completed 6-10-58 19
Application for plugging filed 19
Application for plugging approved 6-10-58 19
Plugging commenced 6-10-58 19
Plugging completed 6-10-58 19
Reason for abandonment of well or producing formation _____

If a producing well is abandoned, date of last production _____ 19
Was permission obtained from the Conservation Division or its agents before plugging was commenced? yes

Name of Conservation Agent who supervised plugging of this well _____
Producing formation _____ Depth to top _____ Bottom _____ Total Depth of Well 3560 Feet
Show depth and thickness of all water, oil and gas formations.

OIL, GAS OR WATER RECORDS

CASING RECORD

FORMATION	CONTENT	FROM	TO	SIZE	PUT IN	PULLED OUT
				8 5/8	215'	none

Describe in detail the manner in which the well was plugged, indicating where the mud fluid was placed and the method or methods used in introducing it into the hole. If cement or other plugs were used, state the character of same and depth placed, from _____ feet to _____ feet for each plug set.

Filled with heavy mud to 600', set plug with 25 sacks cement through drill pipe. Filled with heavy mud to 210', set plug with 15 sacks cement through drill pipe. Filled with heavy mud to 40', set solid bridge with 10 sacks cement to base of cellar. Job complete.

RECEIVED
STATE CORPORATION COMMISSION

JUN 24 1958

CONSERVATION DIVISION
Wichita, Kansas

6-24-58

(If additional description is necessary, use BACK of this sheet)

Name of Plugging Contractor K & E Drilling, Inc.
Address 719 Union Center Bldg. Wichita, Kansas

STATE OF Kansas, COUNTY OF Sedgwick, ss.
L. C. Hay (employee of owner) or (owner or operator) of the above-described well, being first duly sworn on oath, says: That I have knowledge of the facts, statements, and matters herein contained and the log of the above-described well as filed and that the same are true and correct. So help me God.

(Signature) L. C. Hay
L. C. Hay, Nadel & Gussman
623 Union Center, Wichita, Kansas
(Address)

SUBSCRIBED AND SWORN TO before me this 19th day of June, 1958

My commission expires Nov 3, 1960 Notary Public.

PLUGGING
FILE SEC 14 T 5 R 21W
BOOK PAGE 108 LINE 41