


STATE OF KANSAS
STATE CORPORATION COMMISSION

19-147-20084-00-00

Form CP-4

Give All Information Completely
Make Required Affidavit
Mail or Deliver Report to:
Conservation Division
State Corporation Commission
212 No. Market
Wichita, Kansas 67202

WELL PLUGGING RECORD

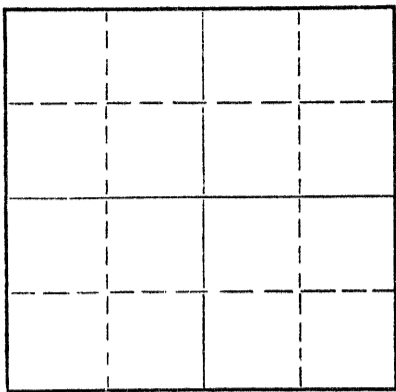

Locate well correctly on above Section Plat

Phillips County. Sec. 34 Twp. 5S Rge. (E)20 (W)
Location as "NE/CNW%SW%" or footage from lines. SW SW SE
Lease Owner Rosen Oil Company
Lease Name Neilson "B" Well No. 1
Office Address 260 Sutton Place, Wichita, Kansas
Character of Well (completed as Oil, Gas or Dry Hole) Dry Hole
Date well completed Dec. 28, 19 69
Application for plugging filed (letter 12/31/69) Dec. 28, 19 69
Application for plugging approved Dec. 28, 19 69
Plugging commenced Dec. 28, 19 69
Plugging completed Dec. 28, 19 69
Reason for abandonment of well or producing formation

If a producing well is abandoned, date of last production 19
Was permission obtained from the Conservation Division or its agents before plugging was commenced? Yes

Name of Conservation Agent who supervised plugging of this well Leo Massey
Producing formation Depth to top Bottom Total Depth of Well 3556 Feet
Show depth and thickness of all water, oil and gas formations.

OIL, GAS OR WATER RECORDS

CASING RECORD

FORMATION	CONTENT	FROM	TO	SIZE	PUT IN	PULLED OUT
		0	218'	8-5/8"	218'	None

Describe in detail the manner in which the well was plugged, indicating where the mud fluid was placed and the method or methods used in introducing it into the hole. If cement or other plugs were used, state the character of same and depth placed, from feet to feet for each plug set.

Filled hole with heavy mud to 750 feet. Set first plug at 750 feet with 70 sacks cement.
Filled hole with heavy mud to 210 feet. Set second plug at 210 feet with 20 sacks cement.
Filled hole with heavy mud to 40 feet. Set third plug at 40 feet with 10 sacks cement.
Pumped cement through drill pipe with Allied Cementing Co., Inc. pump truck. Job complete @ 3:15 PM, Dec. 28, 1969.

RECEIVED
STATE CORPORATION COMMISSION
JAN 5 1969 70
CONSERVATION DIVISION
Wichita, Kansas

1-9-70 7-5-69

(If additional description is necessary, use BACK of this sheet)

Name of Plugging Contractor Gabbert-Jones, Inc.
Address 830 Sutton Place - Wichita, Kansas 67202

STATE OF Kansas, COUNTY OF Sedgwick, ss.
E. E. Hall (employee of owner) or (owner or operator) of the above-described well, being first duly sworn on oath, says: That I have knowledge of the facts, statements, and matters herein contained and the log of the above-described well as filed and that the same are true and correct. So help me God.

(Signature) E. E. Hall

830 Sutton Place, Wichita, Kansas (Address)

Subscribed and sworn to before me this 31 day of December, 19 69

Barbara J. Layton
Barbara J. Layton Notary Public.

