


15-147-00559-00-00

WELL PLUGGING RECORD

Give All Information Completely
Make Required Affidavit
Mail or Deliver Report to:
Conservation Division
State Corporation Commission
800 Bittling Building
Wichita, Kansas

NORTH

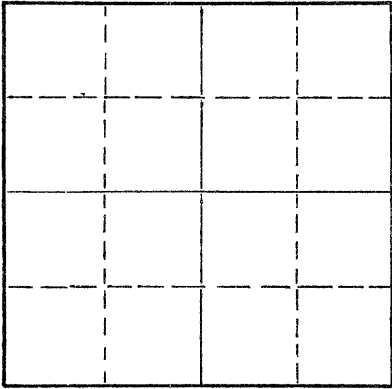

Locate well correctly on above
Section Plat

Phillips County. Sec. 33 Twp. 5 Rge. (E) 20 (W)
Location as "NE/CNW%SW%" or footage from lines 990'S, 990'W of N/4 Corner
Lease Owner Cities Service Oil Co.
Lease Name Hansen B Well No. 3
Office Address Bartlesville, Oklahoma
Character of Well (completed as Oil, Gas or Dry Hole) oil
Date well completed 5/14/42 19
Application for plugging filed 11/30/55 19
Application for plugging approved 12/1/55 19
Plugging commenced 11/30/55 19
Plugging completed 11/30/55 19
Reason for abandonment of well or producing formation 275' of tubing sanded up,
two strings of tools in hole.
If a producing well is abandoned, date of last production August 6, 1955
Was permission obtained from the Conservation Division or its agents before plugging was commenced? yes

Name of Conservation Agent who supervised plugging of this well Mr. Eldon Petty
Producing formation Reagan Sand Depth to top 3531' Bottom Total Depth of Well 3541 Feet
Show depth and thickness of all water, oil and gas formations.

OIL, GAS OR WATER RECORDS

CASING RECORD

FORMATION	CONTENT	FROM	TO	SIZE	PUT IN	PULLED OUT
				8-5/8	155	0
				5 1/2	3531	1118'

Describe in detail the manner in which the well was plugged, indicating where the mud fluid was placed and the method or methods used in introducing it into the hole. If cement or other plugs were used, state the character of same and depth placed, from feet to feet for each plug set.

Mud hole to 158' of surface, set 15' of rock bridge,
dumped 15 sx cement, mud hole to 40', set 10' rock
bridge, dump 10 sx cement, fill to surface with cement.

(If additional description is necessary, use BACK of this sheet)

Name of Plugging Contractor Schull Casing Pulling Co.
Address Great Bend, Kansas


STATE OF KANSAS, COUNTY OF BARTON, ss.
M. M. Hardin (employee of owner) of (operator) of the above-described well, being first duly sworn on oath, says: That I have knowledge of the facts, statements, and matters herein contained and the log of the above-described well as filed and that the same are true and correct. So help me God.

(Signature) M M Hardin

Box 553, Russell, Kansas
(Address)

SUBSCRIBED AND SWORN TO before me this 7th day of December, 1955

My commission expires March 17, 1959
W. G. Smith Notary Public.

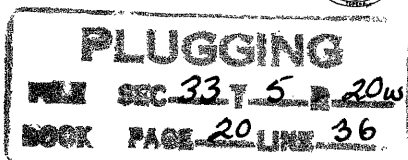

CONSERVATION DIVISION
12-8-55