

STATE CORPORATION COMMISSION OF KANSAS
OIL & GAS CONSERVATION DIVISION

WELL COMPLETION OR RECOMPLETION FORM
ACO-1 WELL HISTORY

DESCRIPTION OF WELL AND LEASE

Operator: License # 9095
Name Grynberg Petroleum Company
Address 5000 S. Quebec
Suite 500
City/State/Zip Denver, Colorado 80237

Purchaser.....

Operator Contact Person Fred R. Davis
Phone (303) 850-7490

Contractor: License # 8682
Name Golden Eagle Drilling Co.

Wellsite Geologist Fred R. Davis
Phone (303) 850-7490

Designate Type of Completion

- New Well Re-Entry Workover
- Oil SWD Temp Abd
- Gas Inj Delayed Comp.
- Dry Other (Core, Water Supply etc.)

If OWWO: old well info as follows:

Operator
Well Name
Comp. Date Old Total Depth.....

WELL HISTORY

Drilling Method:

- Mud Rotary Air Rotary Cable

...3/21/86.. 3/28/86..... 3/29/86.....
Spud Date Date Reached TD Completion Date
...4086! RTD
Total Depth PBDT

Amount of Surface Pipe Set and Cemented at 248 feet
Multiple Stage Cementing Collar Used? Yes No
If yes, show depth set.....feet
If alternate 2 completion, cement circulated
from...248.....feet depth to Surface/175 SX cmt

API NO. 15-~~039-20-729~~.....

County DECATUR.....

Sec. SE 1/4 NW 1/4 Sec. 11 Twp. 4S Rge. 28 East West

.3300..... Ft North from Southeast Corner of Section
.3300..... Ft West from Southeast Corner of Section
(Note: Locate well in section plat below)


Lease Name VACURA Well # 1-11

Field Name WILDCAT

Producing Formation NA

Elevation: Ground 2670' KB 2675'

Section Plat

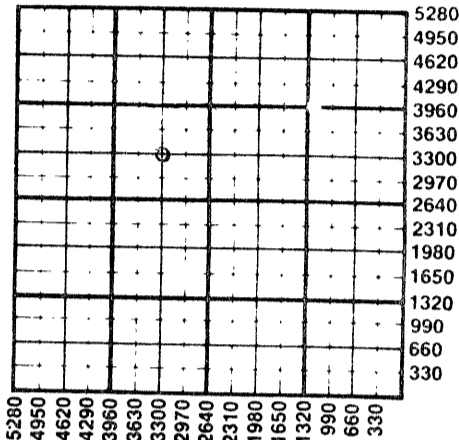

WATER SUPPLY INFORMATION

Disposition of Produced Water: Disposal Repressuring
Docket #

Questions on this portion of the ACO-1 call:
Water Resources Board (913) 296-3717

Source of Water:
Division of Water Resources Permit #.....

Groundwater.....Ft North from Southeast Corner
(Well)Ft West from Southeast Corner of
Sec Twp Rge East West

Surface Water.....Ft North from Southeast Corner
(Stream, pond etc).....Ft West from Southeast Corner
Sec Twp Rge East West

Other (explain).....
(purchased from city, R.W.D. #)

INSTRUCTIONS: This form shall be completed in duplicate and filed with the Kansas Corporation Commission, 200 Colorado Derby Building, Wichita, Kansas 67202, within 90 days after completion or recompletion of any well. Rule 82-3-130 and 82-3-107 apply. Information on side two of this form will be held confidential for a period of 12 months if requested in writing and submitted with the form. See rule 82-3-107 for confidentiality in excess of 12 months. One copy of all wireline logs and drillers time log shall be attached with this form. Submit CP-4 form with all plugged wells. Submit CP-111 form with all temporarily abandoned wells.

All requirements of the statutes, rules and regulations promulgated to regulate the oil and gas industry have been fully complied with and the statements herein are complete and correct to the best of my knowledge.

Signature Fred R. Davis

Title Geologist Date 3/31/86

Subscribed and sworn to before me this 1 day of April 1986

Notary Public Linda L. Magnuson

Date Commission Expires 3-13-90

K.C.C. OFFICE USE ONLY
 Letter of Confidentiality Attached
 Wireline Log Received
 Drillers Timelog Received
Distribution
 KCC SWD/Rep NGPA
 KGS Plug Other (Specify)

Form ACO-1 (7-84)
STATE CORPORATION COMMISSION
APR - 3 1986

Sec. 11 Twp. 4 Rge. 28