


STATE OF KANSAS
STATE CORPORATION COMMISSION

Give All Information Completely
Make Required Affidavit
Mail or Deliver Report to:
Conservation Division
State Corporation Commission
211 No. Broadway
Wichita, Kansas

15-137-00234-00-00
WELL PLUGGING RECORD

NORTH

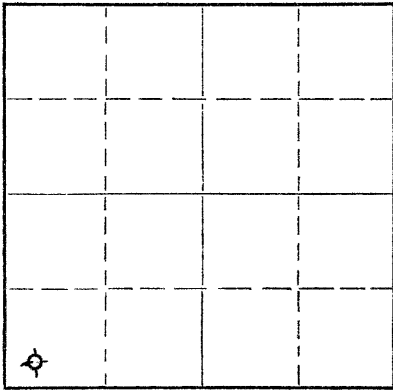

Locate well correctly on above
Section Plat

Norton County. Sec. 7 Twp. 5 Rge. (E) 21 (W)
Location as "NE/CNW%SW%" or footage from lines SW SW SW
Lease Owner D. G. Hansen
Lease Name Noone Well No. 1
Office Address Logan, Kansas
Character of Well (completed as Oil, Gas or Dry Hole) Dry Hole
Date well completed May 28 1957
Application for plugging filed May 28 1957
Application for plugging approved May 28 1957
Plugging commenced May 29 1957
Plugging completed May 29 1957
Reason for abandonment of well or producing formation Too low structurally

If a producing well is abandoned, date of last production _____ 19____
Was permission obtained from the Conservation Division or its agents before plugging was commenced? Yes

Name of Conservation Agent who supervised plugging of this well Eldon Petty, Hays, Kansas
Producing formation _____ Depth to top _____ Bottom _____ Total Depth of Well 3546 Feet
Show depth and thickness of all water, oil and gas formations.

OIL, GAS OR WATER RECORDS

CASING RECORD

FORMATION	CONTENT	FROM	TO	SIZE	PUT IN	PULLED OUT
				8-5/8"	234'	none

Describe in detail the manner in which the well was plugged, indicating where the mud fluid was placed and the method or methods used in introducing it into the hole. If cement or other plugs were used, state the character of same and depth placed, from _____ feet to _____ feet for each plug set.

Filled hole with heavy mud to 225'.
Set plug. Put in 15 sacks of cement
and 1/2 sack Hulls. Filled with heavy
mud up to 20'. Set plug. Filled to
top with 1/2 sack hulls and 15 sacks
of cement.

(If additional description is necessary, use BACK of this sheet)
Name of Plugging Contractor C-G Drilling Co.
Address 107 Rule Building, Wichita, Kansas

STATE OF KANSAS, COUNTY OF SEDGWICK, ss.
Jay H. Galloway (employee of owner) or (owner or operator) of the above-described well, being first duly sworn on oath, says: That I have knowledge of the facts, statements, and matters herein contained and the log of the above-described well as filed and that the same are true and correct. So help me God.

(Signature) Jay H. Galloway
Jay H. Galloway
107 Rule Bldg.
(Address)

SUBSCRIBED AND SWORN TO before me this 4th day of June, 1957

My commission expires May 20, 1959
Vicky Jacobs
Notary Public.

PLUGGING
FILE SEC 1 T. 5 R. 21W
BOOK PAGE 17 LINE 3