

CARD MUST BE TYPED

State of Kansas

CARD MUST BE SIGNED

NOTICE OF INTENTION TO DRILL

(see rules on reverse side)

Starting Date 12-13-85
month day year

API Number 15- 147-20,493-00-00

OPERATOR: License # 6771

NE SE SW Sec. 22 Twp. 5 S, Rg. 20 East
West

Name Ozark Enterprises
Address Box 128

990 Ft. from South Line of Section
2970 Ft. from East Line of Section

City/State/Zip Gainesville, Missouri 65655

(Note: Locate well on Section Plat on reverse side)

Contact Person Steve Morrison

Phone 417-679-3550

Nearest lease or unit boundary line 330 feet

CONTRACTOR: License # 5302

County Phillips

Name Red Tiger Drilling Company

Lease Name Demuth Well # 4

City/State Wichita, Kansas 67202

Well Drilled For: Well Class: Type Equipment:
 Oil SWD Infield Mud Rotary
 Gas Inj Pool Ext. Air Rotary
 OWWO Expl Wildcat Cable

Ground surface elevation 2185 feet MSL

Domestic well within 330 feet: yes no

Municipal well within one mile: yes no

Surface pipe by Alternate: 1 2

If OWWO: old well info as follows:

Depth to bottom of fresh water 150'

Depth to bottom of usable water 725' ~ 1050'

Surface pipe planned to be set 210'

Projected Total Depth 3600' feet

Formation Arbuckle

I certify that well will comply with K.S.A. 55-101, et seq., plus eventually plugging hole to KCC specifications.

Date [redacted] Signature of Operator or Agent [Signature] Title Operator

For KCC Use: Conductor Pipe Required feet; Minimum Surface Pipe Required feet per Alt. 2


This Authorization Expires 6-9-86 Approved By 12-9-85 [Signature]

Must be filed with the K.C.C. five (5) days prior to commencing well
 This card void if drilling not started within six (6) months of date received by K.C.C.

Important procedures to follow:

1. Notify District office before setting surface casing.
2. Set surface casing by circulating cement to the top.
3. File completion forms ACO-1 with K.C.C. within 90 days of well completion, following instructions on ACO-1, side 1, and including copies of wireline logs.
4. Notify District office 48 hours prior to old well workover or re-entry.
5. Prior to filing Intent, prepare a proposed plugging plan in case well is D & A, then obtain approval of plan when calling district office prior to setting surface pipe.
6. Submit plugging report (CP-4) to K. C. C. after plugging is completed.
7. Obtain an approved injection docket number before disposing of salt water.
8. Notify K.C.C. within 10 days when injection commences or terminates.
9. If an alternate 2 completion, cement in the production pipe from below any usable water to surface within 120 days of spud date.

A Regular Section of Land
 1 Mile = 5,280 Ft.

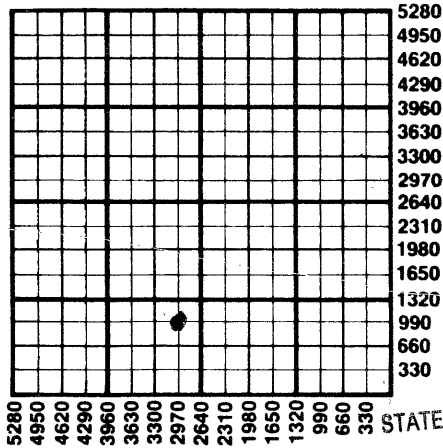

RECEIVED
 STATE CORPORATION COMMISSION

DEC 4 1985
 12-04-1985
 CONSERVATION DIVISION
 Wichita, Kansas

State Corporation Commission of Kansas
 Conservation Division
 200 Colorado Derby Building
 Wichita, Kansas 67202
 (316) 263-3238

DEC 9 1985

CONSERVATION DIVISION
 Wichita, Kansas