


STATE OF KANSAS
STATE CORPORATION COMMISSION

Give All Information Completely
Make Required Affidavit
Mail or Deliver Report to:
Conservation Division
State Corporation Commission
800 Biting Building
Wichita, Kansas

15-147-00707-0000

WELL PLUGGING RECORD

NORTH

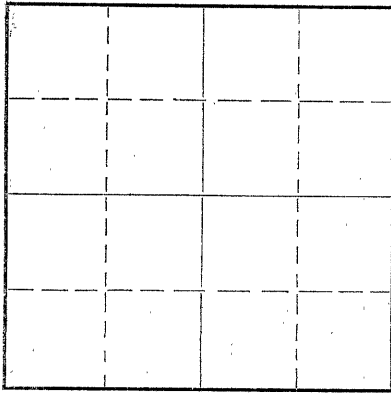

Locate well correctly on above
Section Plat

Phillips County. Sec. 22 Twp. 5S Rge. (E) 20 (W)
Location as "NE/CNW 1/4 SW 1/4" or footage from lines 990' N 330' E of W 1/4 Corner
Lease Owner Cities Service Oil Co.
Lease Name DeMuth Well No. 1
Office Address Bartlesville, Oklahoma
Character of Well (completed as Oil, Gas or Dry Hole) Dry Hole
Date well completed 10-2-50 19
Application for plugging filed 10-2-50 19
Application for plugging approved 10-3-50 19
Plugging commenced 10-4-50 19
Plugging completed 10-4-50 19
Reason for abandonment of well or producing formation

If a producing well is abandoned, date of last production 19
Was permission obtained from the Conservation Division or its agents before plugging was commenced? yes

Name of Conservation Agent who supervised plugging of this well Eldon Petty
Producing formation Arbuckle Lime Depth to top 3591' Bottom Total Depth of Well 3628' Feet
Show depth and thickness of all water, oil and gas formations.

OIL, GAS OR WATER RECORDS

CASING RECORD

Formation	Content	From	To	Size	Put In	Pulled Out
				8-5/8	197'	None

Describe in detail the manner in which the well was plugged, indicating where the mud fluid was placed and the method or methods used in introducing it into the hole. If cement or other plugs were used, state the character of same and depth placed, from feet to feet for each plug set.

Filled with heavy mud to 180', set bridge plug. Put 15 sacks cement.
Heavy mud to 35' of surface. 10 sacks cement to surface.

RECEIVED
STATE CORPORATION COMMISSION
NOV - 04 - 1950
CONSERVATION DIV.
Wichita, Kc

(If additional description is necessary, use BACK of this sheet)

Correspondence regarding this well should be addressed to R. C. Cooper, Cities Service Oil Co.
Address Great Bend, Kansas

STATE OF KANSAS, COUNTY OF BARTON, ss.
James Porter (employee of owner) or (owner or operator) of the above-described well,
being first duly sworn on oath, says: That I have knowledge of the facts, statements, and matters herein contained and the log of the above-described well as filed and that the same are true and correct. So help me God.

(Signature) James Porter
Box 553, Russell, Kansas
(Address)

SUBSCRIBED AND SWORN to before me this 17th day of October 1950
N. E. Smith
Notary Public.

My commission expires 3-17-1951

PLUGGING
FILE SEC 22 T 5 R 204
BOOK PAGE 32 LINE 34

WELL RECORD

15-117-00707-00-00

Company Cities Service Oil Co. Well No. 1 Farm Delkuth
 Location 990' North and 330' East of W/4 Corner Sec. 22 T. 5 R. 20W
 Elevation 2173 (2170 Gr.) County Phillips State Kansas
 Drlg. Comm. September 25, 1950 Contractor H. W. Rine Drilling Company
 Drlg. Comp. October 2, 1950 Acid None
 T. D. 3628' Initial Prod. Dry Hole - P. & A. 10-3-50

CASING RECORD:

8-5/8" @ 197' con. 250 ex cement
 and 200# O. C.

FORMATION RECORD:

shale, sand & shells	0-197
shale & shells	700
sand, shale & shells	1200
sand	1400
red bed & shale	1700
anhydrite	1730
shale	2140
shale & shells	2225
lime & shale	2305
lime, shale & shells	2510
shale, shells & lime	2695
lime & shale	2810
shale	2945
lime	3055
lime & shale	3145
lime	3628 T. D.

Heebner	3293'
Dodge	3316'
Lansing	3334'
Conglomerate	3582'
Arbuckle	3591'
Penetration	37'
Total Depth	3628'

SYFO: 500' 0°
 1000' 0°
 1500' 0°
 2000' 0°
 2500' 0°
 3000' 0°

7-7/8" rotary hole.

Drill stem test 3335-41, recovered
 3' mud in 30 mins.

Drill stem test 3515-43, recovered
 10' muddy water, in 30 mins.
 B. H. P. 670#.

PLUGGING
 FILE SEC 22 T 5 R 20W
 BOOK PAGE 32 LINE 34