


STATE OF KANSAS  
STATE CORPORATION COMMISSION

Give All Information Completely  
Make Required Affidavit  
Mail or Deliver Report to:  
Conservation Division  
State Corporation Commission  
800 Bitting Building  
Wichita, Kansas

15-147-~~00800~~-00-00  
00679  
WELL PLUGGING RECORD

NORTH

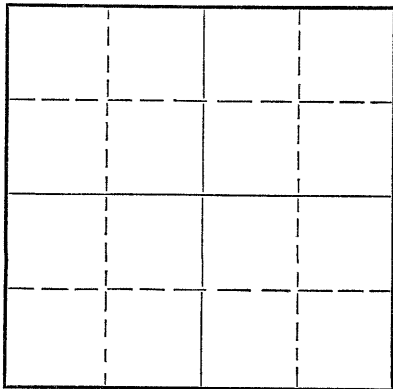

Locate well correctly on above  
Section Plat

Phillips County. Sec. 22 Twp. 5 Rge. (E) 20 (W)  
Location as "NE/CNW $\frac{1}{4}$ SW $\frac{1}{4}$ " or footage from lines NW $\frac{1}{4}$  NW $\frac{1}{4}$  SW $\frac{1}{4}$   
Lease Owner Lewis Drilling Company  
Lease Name Demuth Well No. 1  
Office Address 607 Union National Bank Bldg., Wichita, Kansas  
Character of Well (completed as Oil, Gas or Dry Hole) Dry Hole  
Date well completed 5-3 19 53  
Application for plugging filed 5-3 19 53  
Application for plugging approved 5-5 19 53  
Plugging commenced 5-3 19 53  
Plugging completed 5-3 19 53  
Reason for abandonment of well or producing formation \_\_\_\_\_

If a producing well is abandoned, date of last production \_\_\_\_\_ 19\_\_\_\_  
Was permission obtained from the Conservation Division or its agents before plugging was commenced? Yes

Name of Conservation Agent who supervised plugging of this well Mr. Eldon Petty  
Producing formation \_\_\_\_\_ Depth to top \_\_\_\_\_ Bottom \_\_\_\_\_ Total Depth of Well 3610 Feet  
Show depth and thickness of all water, oil and gas formations.

OIL, GAS OR WATER RECORDS

CASING RECORD

Formation	Content	From	To	Size	Put In	Pulled Out
				8-5/8"	202'	None

Describe in detail the manner in which the well was plugged, indicating where the mud fluid was placed and the method or methods used in introducing it into the hole. If cement or other plugs were used, state the character of same and depth placed, from \_\_\_\_\_ feet to \_\_\_\_\_ feet for each plug set.

**First Plug set @ 190' with 15 Sx Cement**  
**Second plug set @ 40' with 10 Sx Cement on top.**

RECEIVED  
STATE CORPORATION COMMISSION

MAY 19 1953

CONSERVATION DIVISION  
Wichita, Kansas

→ 05-18-1953

(If additional description is necessary, use BACK of this sheet)

Name of Plugging Contractor Lewis Drilling Company  
Address 607 Union National Bank Bldg., Wichita, Kansas

STATE OF KANSAS, COUNTY OF SEDGWICK, ss.  
L. L. Bailey (employee of owner) or (owner or operator) of the above-described well,  
being first duly sworn on oath, says: That I have knowledge of the facts, statements, and matters herein contained and the log of the above-described well as filed and that the same are true and correct. So help me God.

(Signature) L. L. Bailey

607 Union National Bank Bldg., Wichita, Kansas  
(Address)

SUBSCRIBED AND SWORN to before me this 7th day of May, 1953.

My commission expires August 1, 1954

J. M. Connell  
Notary Public.

23-8390-s 8-51-20M

**PLUGGING**  
FILE SEC 22-5-R-20M  
BOOK PAGE 99 LINE 8