


STATE OF KANSAS  
STATE CORPORATION COMMISSION

Give All Information Completely  
Make Required Affidavit  
Mail or Deliver Report to:  
Conservation Division  
State Corporation Commission  
211 No. Broadway  
Wichita, Kansas

15-147-00623-00-00  
WELL PLUGGING RECORD

NORTH

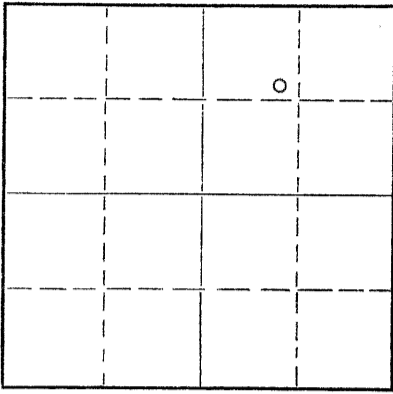

Locate well correctly on above  
Section Plat

Phillips County. Sec. 22 Twp. 5 Rge. 20 (E) W (W)  
Location as "NE/CNW&SW&" or footage from lines SE NW NE  
Lease Owner Colorado Oil and Gas Corporation  
Lease Name DEMUTH Well No. 3  
Office Address Box 1030, Wichita, Kansas  
Character of Well (completed as Oil, Gas or Dry Hole) Oil  
Date well completed April 23 19 49  
Application for plugging filed September 21 19 59  
Application for plugging approved September 23 19 59  
Plugging commenced October 7 19 59  
Plugging completed October 15 19 59  
Reason for abandonment of well or producing formation producing zone depleted

If a producing well is abandoned, date of last production September 1 19 59  
Was permission obtained from the Conservation Division or its agents before plugging was commenced? Yes

Name of Conservation Agent who supervised plugging of this well Eldon Petty  
Producing formation Arbuckle Depth to top 3537 Bottom \_\_\_\_\_ Total Depth of Well 3599 Feet  
Show depth and thickness of all water, oil and gas formations.

OIL, GAS OR WATER RECORDS

CASING RECORD

FORMATION	CONTENT	FROM	TO	SIZE	PUT IN	PULLED OUT
				8-5/8"	277'	None
				4-1/2"	3615'	1520'

Describe in detail the manner in which the well was plugged, indicating where the mud fluid was placed and the method or methods used in introducing it into the hole. If cement or other plugs were used, state the character of same and depth placed, from \_\_\_\_\_ feet to \_\_\_\_\_ feet for each plug set.

Checked the hole to 3599' and found it open. Filled with sand to 3520' and dumped 3 sacks of cement with bailer. Pulled 4-1/2" casing to 550' and circulated with 30 sacks of gel mud and pumped in 20 sacks of cement at 550'. Pulled casing to 180' and pumped in 20 more sacks of cement. Pulled rest of casing, cleared hole and bailed hole to 40', set rock bridge to 30' and ran 10 sacks of cement to base of cellar.

PLUGGING COMPLETED

RECEIVED  
STATE CORPORATION COMMISSION  
OCT 29 1959  
10-29-1959  
CONSERVATION DIVISION  
Wichita, Kansas

(If additional description is necessary, use BACK of this sheet)  
Name of Plugging Contractor Knight Casing Pulling Company  
Address Chase, Kansas

STATE OF Kansas, COUNTY OF Sedgwick, ss.  
Bill K. Henrichs (employee of owner) or (owner or operator) of the above-described well, being first duly sworn on oath, says: That I have knowledge of the facts, statements, and matters herein contained and the log of the above-described well as filed and that the same are true and correct. So help me God.

(Signature) Bill K. Henrichs  
Bill K. Henrichs  
Box 1030, Wichita, Kansas  
(Address)

SUBSCRIBED AND SWORN TO before me this 28th day of October, 1959

Helen L. Martin  
Helen L. Martin Notary Public.

My commission expires August 19, 1963

