

STATE OF KANSAS
STATE CORPORATION COMMISSION


15-147-60704-00-00
WELL PLUGGING RECORD

Give All Information Completely
Make Required Affidavit
Mail or Deliver Report to:
Conservation Division
State Corporation Commission
800 Biting Building
Wichita, Kansas

OR
FORMATION PLUGGING RECORD

Strike out upper line
when reporting plug-
ging off formations.

NORTH

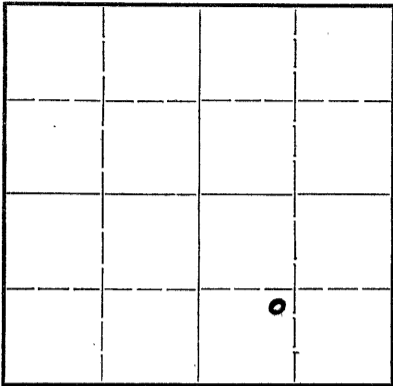

Locate well correctly on above
Section Flat

Phillips County. Sec. 20. Twp. 5s. Rge. 20w. (E) (W)
Location as "NE 1/4 NW 1/4 SW 1/4" or footage from lines. NE SW SE
Lease Owner. D. G. Hansen
Lease Name. Perry V. States Well No. 3
Office Address. Logan, Kansas
Character of Well (completed as Oil, Gas or Dry Hole) Dry Hole
Date well completed. 9/24/47 19
Application for plugging filed. 10/15/47 19
Application for plugging approved. 10/16/47 19
Plugging commenced. 10/10/47 19
Plugging completed. 10/20/47 19
Reason for abandonment of well or producing formation. Dry Hole

If a producing well is abandoned, date of last production. 19
Was permission obtained from the Conservation Division or its agents before plugging was com-
menced? yes

Name of Conservation Agent who supervised plugging of this well. C. D. Stough
Producing formation. None Depth to top. Bottom. Total Depth of Well. 3652 Feet
Show depth and thickness of all water, oil and gas formations.

OIL, GAS OR WATER RECORDS

CASING RECORD

Formation	Content	From	To	Size	Put In	Pulled Out
Top of Lansing	Void	3377		8 5/8	210	Not pulled
Base of Kansas City	"	3590		5 1/2	3633	1325
Top of Arbuckle	Trace oil	3632				
Top of Reagan Sand	Water	3651				

Describe in detail the manner in which the well was plugged, indicating where the mud fluid was placed and the method or methods used in introducing it into the hole. If cement or other plugs were used, state the character of same and depth placed, from feet to feet for each plug set.

Lane-Wells Plug 3511 1/8, filled back to 3375 with sand and dumped 5 sacks cement, filled back with mud to 210 and dumped 15 sacks cement, filled back to 30' and dumped 10 sacks cement.

11-06-1947

(If additional description is necessary, use BACK of this sheet)

Correspondence regarding this well should be addressed to D. G. Hansen
Address. Logan, Kansas

STATE OF Kansas, COUNTY OF Phillips, ss.
Hugh M. King (employee of owner) or (owner or operator) of the above-described well,
being first duly sworn on oath, says: That I have knowledge of the facts, statements, and matters herein contained and the log of the above-described well as filed and that the same are true and correct. So help me God.

(Signature) *Hugh M. King*
Logan, Kansas (Address)

SUBSCRIBED AND SWORN to before me this 31 st. day of October, 19 47.

My commission expires 12-11-47

James H. ...
Notary Public.

