


Give All Information Completely  
Make Required Affidavit  
Mail or Deliver Report to:  
Conservation Division  
State Corporation Commission  
211 No. Broadway  
Wichita, Kansas

WELL PLUGGING RECORD

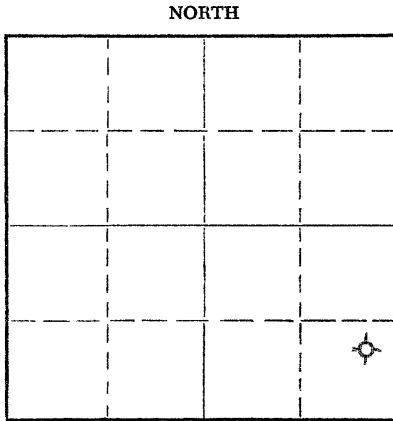

Locate well correctly on above  
Section Plat

Norton County, Sec. 28 Twp. 5 Rge. 21 (E) (W) W  
Location as "NE/CNW/SW" or footage from lines NE SE SE  
Lease Owner D. G. Hansen  
Lease Name Arasmith Well No. 1  
Office Address Logan, Kansas  
Character of Well (completed as Oil, Gas or Dry Hole) Dry Hole  
Date well completed February 2 1960  
Application for plugging filed February 2 1960  
Application for plugging approved February 2 1960  
Plugging commenced February 2 1960  
Plugging completed February 2 1960  
Reason for abandonment of well or producing formation Too low structurally

If a producing well is abandoned, date of last production \_\_\_\_\_ 19\_\_\_\_  
Was permission obtained from the Conservation Division or its agents before plugging was commenced? Yes

Name of Conservation Agent who supervised plugging of this well Eldon Petty, Hays, Kansas  
Producing formation \_\_\_\_\_ Depth to top \_\_\_\_\_ Bottom \_\_\_\_\_ Total Depth of Well 3766 Feet  
Show depth and thickness of all water, oil and gas formations.

OIL, GAS OR WATER RECORDS

CASING RECORD

FORMATION	CONTENT	FROM	TO	SIZE	PUT IN	PULLED OUT
				8-5/8"	236.73'	None

Describe in detail the manner in which the well was plugged, indicating where the mud fluid was placed and the method or methods used in introducing it into the hole. If cement or other plugs were used, state the character of same and depth placed, from \_\_\_\_\_ feet to \_\_\_\_\_ feet for each plug set.

Filled hole with heavy mud to 500'. Set plug. Put in 20 sacks cement. Filled to 180'. Set plug. Put in 1/2 sack hulls and 20 sacks cement. Filled with heavy mud up to 40'. Set plug. Filled to top with 1/2 sack hulls and 10 sacks cement.

RECEIVED

FEB 4 1960

A. G. CUMMINGS

RECEIVED  
STATE CORPORATION COMMISSION  
02-29-1960  
FEB 29 1960

CONSERVATION DIVISION  
Wichita, Kansas

(If additional description is necessary, use BACK of this sheet)  
Name of Plugging Contractor C-G Drilling Co.  
Address 107 Rule Building, Wichita 2, Kansas

STATE OF KANSAS COUNTY OF SEDGWICK, ss.  
G. F. Galloway (employee of owner) or (owner or operator) of the above-described well, being first duly sworn on oath, says: That I have knowledge of the facts, statements, and matters herein contained and the log of the above-described well as filed and that the same are true and correct. So help me God.

(Signature) Jay H. Galloway  
Jay H. Galloway  
107 Rule Building  
(Address)

SUBSCRIBED AND SWORN TO before me this 3rd day of February, 1960

My commission expires May 20, 1963

Vicky Jacobs  
Vicky Jacobs  
Notary Public.