

15-137-00547-00-00


Give All Information Completely  
Make Required Affidavit  
Mail or Deliver Report to:  
Conservation Division  
State Corporation Commission  
211 No. Broadway  
Wichita, Kansas

WELL PLUGGING RECORD

Norton County. Sec. 26 Twp. 5 Rge. (E) 21 (W)  
Location as "NE/CNW/SW" or footage from lines E/2 W/2 NW/4  
Lease Owner Dane G. Hansen Trust  
Lease Name Hansen Fee 'E' Well No. 4  
Office Address Box 187, Logan, Kansas 67646  
Character of Well (completed as Oil, Gas or Dry Hole) Oil  
Date well completed November 17 19 59  
Application for plugging filed December 30 19 75  
Application for plugging approved December 31 19 75  
Plugging commenced February 3 19 76  
Plugging completed February 3 19 76  
Reason for abandonment of well or producing formation Oil depleted

If a producing well is abandoned, date of last production 19  
Was permission obtained from the Conservation Division or its agents before plugging was commenced? Yes

Name of Conservation Agent who supervised plugging of this well Gilbert Balthazor  
Producing formation Arbuckle Depth to top 3673 Bottom 3683 Total Depth of Well 3683 Feet  
Show depth and thickness of all water, oil and gas formations.

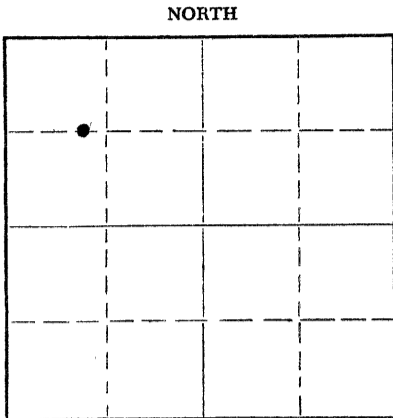

Locate well correctly on above Section Plat

OIL, GAS OR WATER RECORDS

CASING RECORD

FORMATION	CONTENT	FROM	TO	SIZE	PUT IN	PULLED OUT
				8 5/8"	188	None
				5 1/2"	3675	None

Describe in detail the manner in which the well was plugged, indicating where the mud fluid was placed and the method or methods used in introducing it into the hole. If cement or other plugs were used, state the character of same and depth placed, from \_\_\_\_\_ feet to \_\_\_\_\_ feet for each plug set.

Pumped 30 bbls. water down casing.  
Pumped 2 sacks hulls mixed with water.  
Released plug.  
Mixed and pumped 100 sacks cement.  
No pressure.

RECEIVED  
STATE CORPORATION COMMISSION

MAR 19 1976

CONSERVATION DIVISION  
Wichita, Kansas

319-76

(If additional description is necessary, use BACK of this sheet)

Name of Plugging Contractor Allied Cementing Company  
Address Box 31, Russell, Kansas

STATE OF KANSAS, COUNTY OF PHILLIPS, ss.  
Dane G. Bales, Manager (employee of owner) or (owner or operator) of the above-described well, being first duly sworn on oath, says: That I have knowledge of the facts, statements, and matters herein contained and the log of the above-described well as filed and that the same are true and correct. So help me God.

(Signature) Dane G. Bales  
Logan, Kansas 67646  
(Address)

SUBSCRIBED AND SWORN TO before me this 17 day of March, 19 76

Betty Jane Bittel  
Betty Jane Bittel  
Notary Public.

My commission expires

