


STATE OF KANSAS  
STATE CORPORATION COMMISSION

Give All Information Completely  
Make Required Affidavit  
Mail or Deliver Report to:  
Conservation Division  
State Corporation Commission  
211 No. Broadway  
Wichita, Kansas

15-137-00218-00-00  
WELL PLUGGING RECORD

NORTH

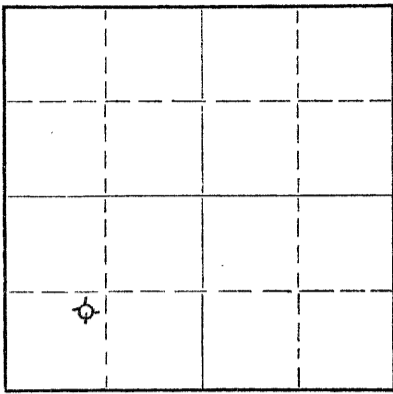

Locate well correctly on above  
Section Plat

Location as "NE/CNW/SW" or footage from lines Norton County. Sec. 26 Twp. 5 Rge. 21W (E) (W)  
Lease Owner D. G. Hansen  
Lease Name Fee "E" Well No. 2  
Office Address Logan, Kansas  
Character of Well (completed as Oil, Gas or Dry Hole) Dry Hole  
Date well completed September 4 1959  
Application for plugging filed September 4 1959  
Application for plugging approved September 4 1959  
Plugging commenced September 4 1959  
Plugging completed September 4 1959  
Reason for abandonment of well or producing formation Too low structurally

If a producing well is abandoned, date of last production \_\_\_\_\_ 19\_\_\_\_  
Was permission obtained from the Conservation Division or its agents before plugging was commenced? Yes

Name of Conservation Agent who supervised plugging of this well Eldon Petty, Hays, Kansas  
Producing formation \_\_\_\_\_ Depth to top \_\_\_\_\_ Bottom \_\_\_\_\_ Total Depth of Well 3807 Feet  
Show depth and thickness of all water, oil and gas formations.

OIL, GAS OR WATER RECORDS

CASING RECORD

FORMATION	CONTENT	FROM	TO	SIZE	PUT IN	PULLED OUT
				8-5/8"	155.51'	None

Describe in detail the manner in which the well was plugged, indicating where the mud fluid was placed and the method or methods used in introducing it into the hole. If cement or other plugs were used, state the character of same and depth placed, from \_\_\_\_\_ feet to \_\_\_\_\_ feet for each plug set.

Filled hole with heavy mud to 500'. Set plug. Put in 20 sacks cement. Filled to 155'. Set plug. Put in 1/2 sack hulls and 20 sacks cement. Filled with heavy mud up to 50'. Set plug. Filled to top with 1/2 sack hulls and 10 sacks cement.

RECEIVED  
STATE CORPORATION COMMISSION

DEC 11 1959

CONSERVATION DIVISION  
Wichita

12-11-59

(If additional description is necessary, use BACK of this sheet)  
Name of Plugging Contractor C-G DRILLING CO.  
Address 107 Rule Building, Wichita 2, Kansas

STATE OF KANSAS, COUNTY OF SEDGWICK, ss.  
G. F. Galloway (employee of owner) or (owner or operator) of the above-described well, being first duly sworn on oath, says: That I have knowledge of the facts, statements, and matters herein contained and the log of the above-described well as filed and that the same are true and correct. So help me God.

(Signature) G. F. Galloway  
107 Rule Building  
(Address)

SUBSCRIBED AND SWORN TO before me this 9th day of September, 1959

My commission expires May 20, 1963

Vicky Jacobs  
Notary Public.

