

15-137-00713-00-00

Give All Information Completely
Make Required Affidavit
Mail or Deliver Report to:
Conservation Division
State Corporation Commission
212 No. Market
Wichita, Kansas

WELL PLUGGING RECORD

Norton County, Sec 27 Twp. 5S Rge. 21W (E) (W)

Location as "NE/CNW/SW" or footage from lines NE NE NW

Lease Owner VARN PETROLEUM COMPANY

Lease Name KENDRICK Well No. 2

Office Address 502 CENTRAL BUILDING, WICHITA, KANSAS

Character of Well (completed as Oil, Gas or Dry Hole) OIL WELL

Date well completed _____ 19__

Application for plugging filed MARCH 18 1966

Application for plugging approved _____ 19__


Plugging commenced MARCH 29 1966

Plugging completed MARCH 31 1966

Reason for abandonment of well or producing formation DEPLETED

If a producing well is abandoned, date of last production _____ 19__

Was permission obtained from the Conservation Division or its agents before plugging was commenced? YES

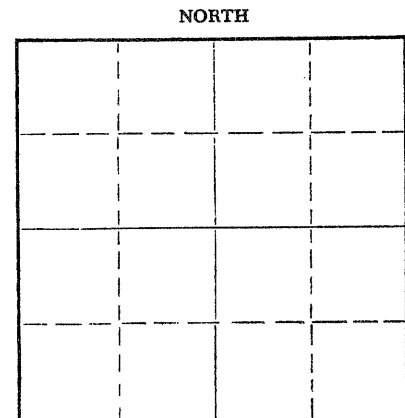

Locate well correctly on above Section Plat

Name of Conservation Agent who supervised plugging of this well W.L. NICHOLS

Producing formation _____ Depth to top _____ Bottom _____ Total Depth of Well 3639 Feet

Show depth and thickness of all water, oil and gas formations.

OIL, GAS OR WATER RECORDS

CASING RECORD

FORMATION	CONTENT	FROM	TO	SIZE	PUT IN	PULLED OUT
				8 5/8"	214'	NONE
				5 1/2"	3637 1/2'	2207'

Describe in detail the manner in which the well was plugged, indicating where the mud fluid was placed and the method or methods used in introducing it into the hole. If cement or other plugs were used, state the character of same and depth placed, from _____ feet to _____ feet for each plug set.

3639' - 3625' - SAND
 3625' - 3585' - 5 SACKS CEMENT
 3585' - 490' - 15 SACKS GEL MUD & 20 SACKS OF CEMENT
 490' - 150' - 20 SACKS CEMENT
 150' - 35' - MUD
 35' - 30' - ROCK BRIDGE
 30' - BASE - 10 SACKS CEMENT

RECEIVED
STATE CORPORATION COMMISSION
APR 11 1966
04-11-66
CONSERVATION DIVISION
Wichita, Kansas

(If additional description is necessary, use BACK of this sheet)
 Name of Plugging Contractor SANTA-FE PIPE & SUPPLY, INC.
 Address BOX 562, GREAT BEND, KANSAS

STATE OF KANSAS, COUNTY OF BARTON, ss. T.L. NUTT (employee of owner) or (owner or operator) of the above-described well, being first duly sworn on oath, says: That I have knowledge of the facts, statements, and matters herein contained and the log of the above-described well as filed and that the same are true and correct. So help me God.

(Signature) T.L. Nutt
BOX 562, GREAT BEND, KANSAS
 (Address)

SUBSCRIBED AND SWORN to before me this 31 day of MARCH, 19 66

My commission expires JULY 31, 1966
Mary M. Suesnier Notary Public.

15737-00713-00-00 COPY


WELL LOG BUREAU—KANSAS GEOLOGICAL SOCIETY
508 East Murdock, Wichita, Kansas

Company- JOCEYLN-VARN
Farm- Kendrick No. 2

SEC. 27 T. 5 R. 21W
NE NE NW

Total Depth. 3639'
Comm. 7-9-58 Comp. 7-20-58
Shot or Treated.
Contractor. Trusco Drlg.
Issued. 5-23-59

County Norton
KANSAS

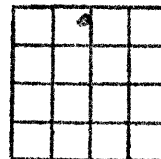

Elevation. 2208' DF

Production. 50 BOPD

Figures indicate Bottom of Formations.

DRILLERS LOG NOT AVAILABLE

TOPS:

Heebner 3353
Toronto 3380
Lansing-Kansas City 3399
Gorham Sand 3632
Arbuckle 3636
Rotary Total Depth

DST 3629-3634' op 1 hr, rec. 4' clean
oil & 10' oil cut mud, IFP O#, FFP O#,
IBHP O#/20 min, FBHP 360#/20 min.