


15-137-00713-00-00

WELL PLUGGING RECORD

Give All Information Completely
Make Required Affidavit
Mail or Deliver Report to:
Conservation Division
State Corporation Commission
211 No. Broadway
Wichita, Kansas

Norton County. Sec. 27 Twp. 58 Rge. 21 (E) W (W)

Location as "NE/CNW/SW" or footage from lines NE NE NW
Lease Owner Varn Petroleum Company
Lease Name Kendrick Well No. 2
Office Address 502 Central Bldg., Wichita, Kansas
Character of Well (completed as Oil, Gas or Dry Hole) oil
Date well completed 7-20-58 19
Application for plugging filed 3-18-66 19
Application for plugging approved 3-31-66 19
Plugging commenced 3-29-66 19
Plugging completed 3-31-66 19
Reason for abandonment of well or producing formation Reached economical limit

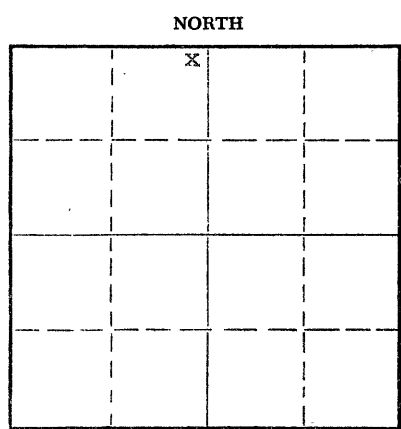

Locate well correctly on above Section Plat

If a producing well is abandoned, date of last production 2-4-66 19
Was permission obtained from the Conservation Division or its agents before plugging was commenced? yes

Name of Conservation Agent who supervised plugging of this well unknown
Producing formation Arbuckle Depth to top 3636 Bottom 3639 Total Depth of Well 3639 Feet
Show depth and thickness of all water, oil and gas formations.

OIL, GAS OR WATER RECORDS

CASING RECORD

FORMATION	CONTENT	FROM	TO	SIZE	PUT IN	PULLED OUT
Topeka	SSO	3312	3318	5 1/2"	3637	2196
Toronto	nil	3380	3394			
Arbuckle	oil	3636	3639			

Describe in detail the manner in which the well was plugged, indicating where the mud fluid was placed and the method or methods used in introducing it into the hole. If cement or other plugs were used, state the character of same and depth placed, from _____ feet to _____ feet for each plug set.

Dumped sand and gravel 3639-3625. Dumped 5 sacks of cement from 3625-3585 w/dump bailer. Shot 5 1/2" casing at 2196'. Pulled casing up to 550'. Pumped 15 sacks of gel mud and 20 sacks cement filled up to 490'. Pulled casing to 210' pumped 20 sacks of cement filled up to 150'. Pulled casing, put 5' rock bridge 35'-30'. Dumped 10 sacks of cement to surface.

RECEIVED
STATE CORPORATION COMMISSION
APR 12 1966
CONSERVATION DIVISION
Wichita, Kansas

(If additional description is necessary, use BACK of this sheet)
Name of Plugging Contractor Santa Fe Pipe & Supply, Inc. 4-12-66
Address Box 562, Great Bend, Kansas

STATE OF Kansas, COUNTY OF Sedgwick, ss.
Jack M. Dotson (employee of owner) or (owner or operator) of the above-described

well, being first duly sworn on oath, says: That I have knowledge of the facts, statements, and matters herein contained and the log of the above-described well as filed and that the same are true and correct. So help me God. VARN PETROLEUM COMPANY

(Signature) Jack M. Dotson
502 Central Bldg., Wichita, Kansas (Address)

SUBSCRIBED AND SWORN TO before me this 11th day of April, 19 66

My commission expires 6-25-68 Notary Public.