

15-137-00712-00-00

STATE OF KANSAS
STATE CORPORATION COMMISSION

Form CP-4

WELL PLUGGING RECORD

Give All Information Completely
Make Required Affidavit
Mail or Deliver Report to:
Conservation Division
State Corporation Commission
211 No. Broadway
Wichita, Kansas

Norton County, Sec. 27 Twp. 5S Rge. 21 (E) W (W)

Location as "NE/CNW/SW" or footage from lines SE SE NW

Lease Owner Varn Petroleum Company

Lease Name Kendrick Well No. 1

Office Address 502 Central Bldg., Wichita, Kansas

Character of Well (completed as Oil, Gas or Dry Hole) oil

Date well completed 9-23-57 19

Application for plugging filed 3-18-66 19

Application for plugging approved 3-21-66 19


Plugging commenced 3-25-66 19

Plugging completed 3-27-66 19

Reason for abandonment of well or producing formation Reached economical limit

If a producing well is abandoned, date of last production 2-4-66 19

Was permission obtained from the Conservation Division or its agents before plugging was commenced? yes

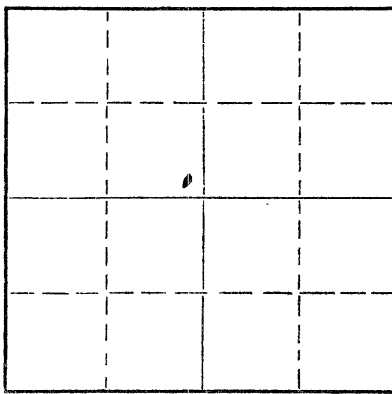

Locate well correctly on above Section Plat

Name of Conservation Agent who supervised plugging of this well unknown

Producing formation Reagan Sand Depth to top 3599 Bottom 3603 Total Depth of Well 3603 Feet

Show depth and thickness of all water, oil and gas formations.

OIL, GAS OR WATER RECORDS

CASING RECORD

FORMATION	CONTENT	FROM	TO	SIZE	PUT IN	PULLED OUT
Topeka	trace oil	3282	3286	5 1/2	3602	2180
Toronto	Stain	3348	3353			
Lansing K. C.	nil	3398	3400			
Reagan Sand	oil	3599	3603			

Describe in detail the manner in which the well was plugged, indicating where the mud fluid was placed and the method or methods used in introducing it into the hole. If cement or other plugs were used, state the character of same and depth placed, from _____ feet to _____ feet for each plug set.

Dumped sand and gravel 3603-3585. Dumped 5 sacks cement w/dump bailer 3585-3545. Shot casing 2180' pulled casing to 540'. Pumped 18 sacks gel mud, pulled casing to 474', pumped 20 sacks of cement back to 414'. Pulled casing to 210'. Pumped 20 sacks of cement back to 150'. Pulled casing out put 5' rock bridge from 35' to 30'. Pumped 30 sacks cement to surface.

RECEIVED
STATE CORPORATION COMMISSION

APR 12 1966

CONSERVATION DIVISION
Wichita, Kansas

(If additional description is necessary, use BACK of this sheet)
Name of Plugging Contractor Santa Fe Pipe & Supply, Inc. 472-66
Address Box 562, Great Bend, Kansas.

STATE OF Kansas, COUNTY OF Sedgwick, ss.
Jack M. Dotson (employee of owner) or (owner or operator) of the above-described well, being first duly sworn on oath, says: That I have knowledge of the facts, statements, and matters herein contained and the log of the above-described well as filed and that the same are true and correct. So help me God. VARN PETROLEUM COMPANY

(Signature) Jack M. Dotson
502 Central Bldg., Wichita, Kansas
(Address)

SUBSCRIBED AND SWORN TO before me this 11th day of April, 1966

My commission expires 6-25-68 Notary Public.